

Tate
 B 2007
 5/17/76

MISSISSIPPI
 BOARD OF WATER COMMISSIONERS
 416 North State Street
 158 Jackson, Mississippi 39201

WATER WELL DRILLERS LOG

5-17-1976 date well completed Bob Southwell firm name Tate county well located

LANDOWNER:
 Cleveland Piquet
 Coldwater, Miss.
 (mailing address)

description of formations encountered	from	to
	top soil	0
red clay	5	40
white sand	40	90

WELL LOCATION:
 sec. 2 T. 4 N. R. 7 E.
 S miles NE of Coldwater
 (distance) (direction) (nearest town)

WELL PURPOSE:
 (home, irrigation, municipal, industrial)

- WELL COMPLETION DATA:
- (1) diameter (inches) 4"
 - (2) total depth (feet) 90'
 - (3) static water level (feet) 60' below top of ground.
 - (4) casing plastic, 90'
 (material) (depth)
 - _____ if telescope see back.
 (size)
 - (5) screen 10' 80'
 (length) (depth to top)
 - 4" plastic
 (size) (material)
 - (6) pump 1/3 5
 (HP) (yield gpm)
 - Elec.
 (type power)
 - (7) electric log (yes or no) _____
 - _____ (organization running log)
 - (8) how well bottom plugged _____


DRILLERS REMARKS:

RECEIVED
 SEP 20 1976

MISS. BD. OF WATER COMMISSIONERS

If well telescopes please sketch and show depths.

GROUND LEVEL

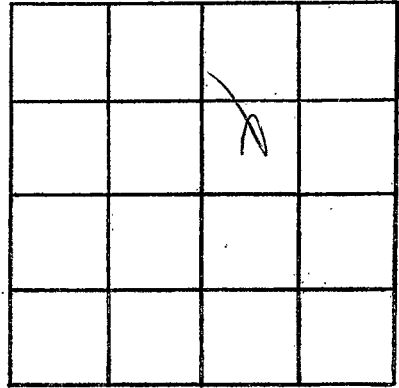

SECTION _____

Please indicate well location X.

ADDITIONAL INFORMATION

If more than one screen,
show locations of each on sketch.