

Late
B 2008
7-2-76

MISSISSIPPI
 BOARD OF WATER COMMISSIONERS
 416 North State Street
 15E Jackson, Mississippi 39201

WATER WELL DRILLERS LOG

7-2-76 19 Late Bob Smith Well Sv. Late
 date well completed firm name county well located


LANDOWNER:	description of formations encountered	from	to
<u>L. E. Hellen</u>			
<u>Coldwater, Miss.</u> (mailing address)	<u>top soil</u>	<u>0</u>	<u>5</u>
	<u>hard clay</u>	<u>5</u>	<u>60</u>
	<u>red gravel</u>	<u>60</u>	<u>90</u>
	<u>sand</u>	<u>90</u>	<u>140</u>
WELL LOCATION: sec. <u>10</u> T. <u>54</u> N. R. <u>7</u> E. <u>6</u> miles <u>NE</u> of <u>Coldwater</u> (distance) (direction) (nearest town)			
WELL PURPOSE: (home, irrigation, municipal, industrial)			
WELL COMPLETION DATA:			
(1) diameter (inches) <u>4"</u>			
(2) total depth (feet) <u>140</u>			
(3) static water level (feet) <u>115</u> below top of ground.			
(4) casing <u>plastic</u> , <u>140</u> (material) (depth)			
(size) if telescope see back.			
(5) screen <u>10</u> <u>130</u> (length) (depth to top)			
<u>4"</u> <u>plastic</u> (size) (material)			
(6) pump <u>1/2</u> <u>10</u> (HP) (yield gpm)			
<u>E see</u> (type power)			
(7) electric log (yes or no) <u>no</u>			
(organization running log)			
(8) how well bottom <u>plugged</u>			
DRILLERS REMARKS:			

RECEIVED
 SEP 20 1976

MISSISSIPPI BOARD OF WATER COMMISSIONERS

If well telescopes please sketch and show depths.

GROUND LEVEL

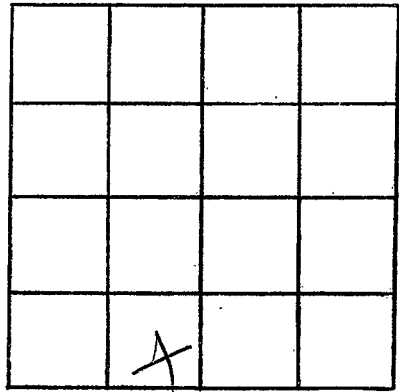

SECTION _____

Please indicate well location X.

ADDITIONAL INFORMATION

If more than one screen,
show locations of each on sketch.