

Tate  
 B 2009  
 4-26-77

MISSISSIPPI  
 BOARD OF WATER COMMISSIONERS  
 416 North State Street  
 Jackson, Mississippi 39201

WATER WELL DRILLERS LOG

4-26 1977 Bicks Well Co. Tate  
 date well completed firm name county well located

LANDOWNER: Freddie Douglas  
 Rt. 4  
 Coldwater, Mo.  
 (mailing address)

description of formations encountered	from	to
Red Clay	0	20
Red Sand & Gravel	20	60
White Clay	60	95
White Sand	95	155

WELL LOCATION:  
 sec. 32 T 4 N R 78 E  
 6 miles W of Coldwater  
 (distance) (direction) (nearest town)

WELL PURPOSE: drone  
 (home, irrigation, municipal, industrial)

- WELL COMPLETION DATA:
- (1) diameter (inches) 4
  - (2) total depth (feet) 155
  - (3) static water level (feet) 100 below above top of ground.
  - (4) casing PVC, 155,  
 (material) (depth)  
 (size) if telescope see back.
  - (5) screen 7' 148'  
 (length) (depth to top)  
4" gravel type  
 (size) (material)
  - (6) pump 1/2 10  
 (HP) (yield gpm)  
220V  
 (type power)
  - (7) electric log No  
 (yes or no)

(organization running log)  
 (8) how well bottom plugged Cap


DRILLERS REMARKS:

RECEIVED  
 MAY 13 1977

MISS. Bd. OF WATER COMMISSIONERS

If well telescopes please sketch and show depths.

GROUND LEVEL

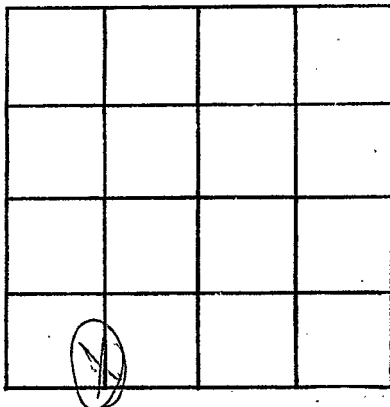

SECTION 32

Please indicate well location 'X':

ADDITIONAL INFORMATION

If more than one screen, show locations of each on sketch.