

Tate
 B 2011
 4-13-77

MISSISSIPPI
 BOARD OF WATER COMMISSIONERS
 416 North State Street
 Jackson, Mississippi 39201

WATER WELL DRILLERS LOG

4-13 77 *Dicks Well Co.* Tate
 date well completed firm name county well located

LANDOWNER: *Robert Ferguson*
Rt. 3
Coldwater, Mo.
 (mailing address)

description of formations encountered	from	to
<i>Red Clay</i>	<i>0</i>	<i>10</i>
<i>Sand & Gravel</i>	<i>10</i>	<i>20</i>
<i>White Sand</i>	<i>20</i>	<i>90</i>
<i>Clay & Sand</i>	<i>90</i>	<i>115</i>

WELL LOCATION:
 sec. *14* T *4* N R *7* E
 (distance) miles (direction) of *Palatka* (nearest town)

WELL PURPOSE: *Home*
 (home, irrigation, municipal, industrial)

- WELL COMPLETION DATA:
- (1) diameter (inches) *4"*
 - (2) total depth (feet) *115*
 - (3) static water level (feet) *60* below above top of ground.
 - (4) casing *PVC*, *115*, (material) (depth)
 (size) if telescope see back.
 - (5) screen *7/8"*, *92'* (length) (depth to top)
4", *garnet type* (size) (material)
 - (6) pump *1/2*, *10* (HP) (yield gpm)
220V (type power)
 - (7) electric log *No* (yes or no)

(organization running log)
 (8) how well bottom plugged *Gravel and sand*


DRILLERS REMARKS:

RECEIVED
 MAY 13 1977

MISS. BD. OF WATER COMMISSIONERS

If well telescopes please sketch and show depths.

GROUND LEVEL

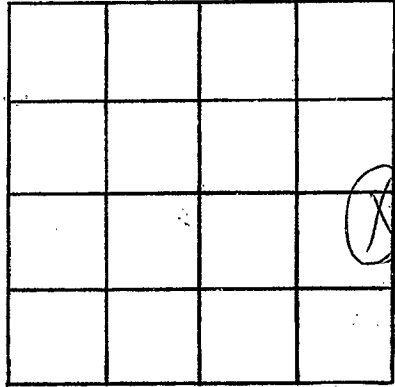

SECTION 14

Please indicate well location X.

ADDITIONAL INFORMATION

If more than one screen, show locations of each on sketch.