

Date
 B 2012
 6-21-77

MISSISSIPPI
 BOARD OF WATER COMMISSIONERS
 416 North State Street
 Jackson, Mississippi 39201

WATER WELL DRILLERS LOG

6-21-77 date well completed
 Harris Bros. firm name
 Date county well located

LANDOWNER: Clyde Sullivan
 Rt. 3 Box 104
 Coldwater
 (mailing address)

description of formations encountered	from	to
top soil	0	20
clay + sand	20	100
coarse sand	100	120

WELL LOCATION:
 sec. 1 T 4 N R 7 E
 7.5 miles NE of Coldwater
 (distance) (direction) (nearest town)

WELL PURPOSE: none
 (home, irrigation, municipal, industrial)

- WELL COMPLETION DATA:
- (1) diameter (inches) 4
 - (2) total depth (feet) 120
 - (3) static water level (feet) 80 ^{below}/_{above} top of ground.
 - (4) casing Plastic, 113 (material) (depth)
 4 (size) If telescope see back.
 - (5) screen 7, 113 (length) (depth to top)
 008 Plastic (size) (material)
 - (6) pump 3/4, 7 (HP) (yield gpm)
 elec. (type power)
 - (7) electric log no (yes or no)

(organization running log)
 (8) how well bottom plugged solid


DRILLERS REMARKS:

RECEIVED
 SEP 20 1977

MISS. BD. OF WATER COMMISSIONERS

If well telescopes please sketch and show depths.

GROUND LEVEL

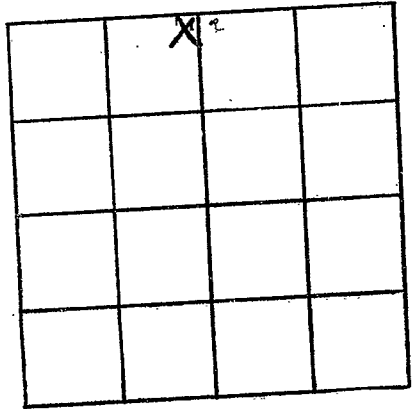

SECTION 7

Please indicate well location X.

ADDITIONAL INFORMATION

If more than one screen, show locations of each on sketch.