

late  
B 203  
8-13-77

MISSISSIPPI  
 BOARD OF WATER COMMISSIONERS  
 416 North State Street  
 Jackson, Mississippi 39201

WATER WELL DRILLERS LOG

8-13 1977 Harris Bros. late  
 date well completed firm name county well located


LANDOWNER: <u>C. F. Mullins</u>	description of formations encountered	from	to
<u>At. 1</u>			
<u>Coldwater</u> (mailing address)	<u>top soil</u>	<u>0</u>	<u>20</u>
WELL LOCATION: sec <u>30</u> T <u>4</u> N R <u>7</u> E <u>1/2</u> miles <u>N</u> of <u>Coldwater</u> (distance) (direction) (nearest town)	<u>fine sand</u>	<u>20</u>	<u>80</u>
WELL PURPOSE: <u>home</u> (home, irrigation, municipal, industrial)	<u>Coarse sand</u>	<u>80</u>	<u>100</u>
WELL COMPLETION DATA: (1) diameter (inches) <u>4</u>			
(2) total depth (feet) <u>100</u>			
(3) static water level (feet) <u>60</u> <u>below</u> above top of ground.			
(4) casing <u>plastic</u> , <u>93</u> (material) (depth)			
<u>4</u> (size) if telescope see back.			
(5) screen <u>7</u> , <u>93</u> (length) (depth to top)			
<u>008</u> , <u>Plastic</u> (size) (material)			
(6) pump <u>1</u> , <u>15</u> (HP) (yield gpm)			
<u>elec</u> (type power)			
(7) electric log <u>AL</u> (yes or no)			
(organization running log)			
(8) how well bottom plugged <u>solid</u>			
DRILLERS REMARKS:			

**RECEIVED**  
 SEP 30 1977

MISS. BU. OF WATER COMMISSIONERS

If well telescopes please sketch and show depths.

GROUND LEVEL

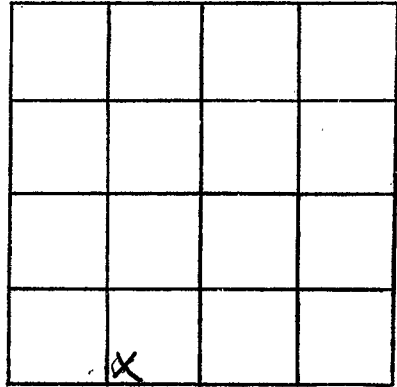

SECTION 30

Please indicate well location X.

ADDITIONAL INFORMATION

If more than one screen,  
show locations of each on sketch.