

LATE  
 B 2014  
 9/15/77

MISSISSIPPI  
 BOARD OF WATER COMMISSIONERS  
 416 North State Street  
 Jackson, Mississippi 39201

WATER WELL DRILLERS LOG

9-15 1977 date well completed  
 Harris Bros. firm name  
 Lata county well located


LANDOWNER	description of formations encountered	from	to
Phillip Hoch <del>2577</del> Rt. 3 Coldwater (mailing address)	top soil	0	20
	sand + clay	20	80
WELL LOCATION: sec. 27 T 4 N R 7 E 2 1/2 miles S E of Coldwater (distance) (direction) (nearest town)	Coarse sand	80	100
WELL PURPOSE: <u>home</u> (home, irrigation, municipal, industrial)			
WELL COMPLETION DATA:			
(1) diameter (inches) <u>4</u>			
(2) total depth (feet) <u>100</u>			
(3) static water level (feet) <u>60</u> <u>below</u> top of ground.			
(4) casing <u>Plastic</u> , <u>93</u> (material) (depth) <u>4</u> (size) if telescope see back.			
(5) screen <u>7</u> , <u>93</u> (length) (depth to top)			
(6) pump <u>008</u> , <u>Plastic</u> (size) (material)			
(6) pump <u>3/4</u> , <u>10</u> (HP) (yield gpm)			
<u>elec</u> (type power)			
(7) electric log <u>no</u> (yes or no)			
(organization running log)			
(8) how well bottom plugged <u>solid</u>			
DRILLERS REMARKS:			

RECEIVED

APR - 6 1978

If well telescopes please sketch and show depths.

GROUND LEVEL

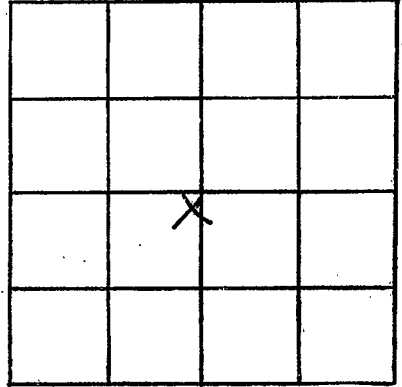

SECTION 27

Please indicate well location X.

ADDITIONAL INFORMATION

If more than one screen, show locations of each on sketch.