

TATE
B 2015

MISSISSIPPI
BOARD OF WATER COMMISSIONERS
416 North State Street
Jackson, Mississippi 39201

WATER WELL DRILLERS LOG

Date

12-16-77 date well completed Bob Smith firm name Date county well located

LANDOWNER:
E. Edge Field
Colquhoun, Miss.
(mailing address)

description of formations encountered	from	to
top soil	0	5
red clay	5	40
gravel	40	60
blue clay	60	150
sand	150	190

WELL LOCATION:
31 ~~15~~ N R 2 E W
0 miles 0 of Calhoun
(distance) (direction) (nearest town)

WELL PURPOSE:
(home, irrigation, municipal, industrial)

WELL COMPLETION DATA:
(1) diameter (inches) 4"
(2) total depth (feet) 190
(3) static water level (feet) 10 below top of ground
(4) casing (material) plastic (depth) 190
(size) if telescope see back.
(5) screen 20 170 (length) (depth to top)
4" (size) (material) plastic
(6) pump 3/4 10 (HP) (yield gpm)
E. L. (type power)
(7) electric log (yes or no)
(organization running log)
(8) how well bottom plugged


DRILLERS REMARKS:

RECEIVED
MAY 30 1978

MISS. BD. OF WATER COMMISSIONERS

If well telescopes please
sketch and show depths.

GROUND LEVEL

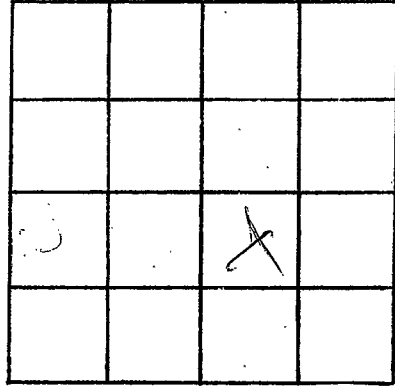

SECTION _____

Please indicate well location X.

ADDITIONAL INFORMATION

If more than one screen,
show locations of each on sketch.