

TATE
 B 2006
3-9-78

MISSISSIPPI
 BOARD OF WATER COMMISSIONERS
 416 North State Street
 Jackson, Mississippi 39201

WATER WELL DRILLERS LOG

3-9-78 1978 Deck Well Co. Tate
 date well completed firm name county well located


LANDOWNER: <u>J. B. Roberts</u>	description of formations encountered	from	to
<u>Coldwater, Ms.</u> (mailing address)	<u>Red Clay</u>	<u>0</u>	<u>40</u>
WELL LOCATION: sec. <u>31</u> T <u>4</u> N R <u>9</u> E <u>5</u> miles <u>W</u> of <u>Coldwater</u> (distance) (direction) (nearest town)	<u>Red Clay + Gravel</u>	<u>40</u>	<u>90</u>
	<u>Black Clay</u>	<u>90</u>	<u>250</u>
	<u>White Sand</u>	<u>250</u>	<u>275</u>
WELL PURPOSE: <u>Home</u> (home, irrigation, municipal, industrial)			
WELL COMPLETION DATA:			
(1) diameter (inches) <u>4</u>			
(2) total depth (feet) <u>275</u>			
(3) static water level (feet) <u>250</u> below top of ground.			
(4) casing <u>PVC</u> , <u>275</u> , (material) (depth)			
____ (size) if telescope see back.			
(5) screen <u>14"</u> , <u>261</u> (length) (depth to top)			
<u>4"</u> , <u>PVC + Gravel</u> (size) (material)			
(6) pump <u>3/4</u> , <u>10</u> (HP) (yield gpm)			
<u>220V</u> (type power)			
(7) electric log <u>No</u> (yes or no)			
____ (organization running log)			
(8) how well bottom plugged <u>Cap</u>			
DRILLERS REMARKS:			

RECEIVED
 MAY 1 - 1978

MISS. BD. OF WATER COMM.

If well telescopes please sketch and show depths.

GROUND LEVEL

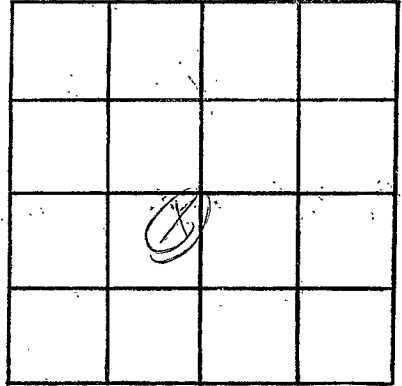

SECTION 31

Please indicate well location X.

ADDITIONAL INFORMATION

If more than one screen,
show locations of each on sketch.