

TATE  
 B. 207  
 5-31-78

MISSISSIPPI  
 BOARD OF WATER COMMISSIONERS  
 416 North State Street  
 Jackson, Mississippi 39201

WATER WELL DRILLERS LOG


5-31-1978 date well completed      Hicks Well Co firm name      Tate county well located

LANDOWNER: Mary Ann Sturdyant      description of formations encountered  
Sturdyant  
Box 3, Box 519  
Caldwater, Mo.      Red clay      from 0 to 20  
 (mailing address)      Red sand      20 90

WELL LOCATION:  
 sec 23 T 4 N 7 E  
2 miles NE of Caldwater  
 (distance) (direction) (nearest town)  
 White sand      90 126

WELL PURPOSE: Home  
 (home, irrigation, municipal, industrial)

WELL COMPLETION DATA:  
 (1) diameter (inches) 4  
 (2) total depth (feet) 126  
 (3) static water level (feet) 60 below above top of ground.  
 (4) casing PVC, 126  
 (material) (depth)  
 (size) If telescope see back.  
 (5) screen 7, 119'  
 L (length) (depth to top)  
4 gravel type  
 (size) (material)  
 (6) pump 42 10  
 (HP) (yield gpm)  
220V  
 (type power)  
 (7) electric log No  
 (yes or no)  
 (organization running log)  
 (8) how well bottom plugged Cap

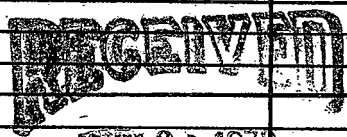


JUN 29 1978

DRILLERS REMARKS:

If well telescopes please sketch and show depths.

GROUND LEVEL

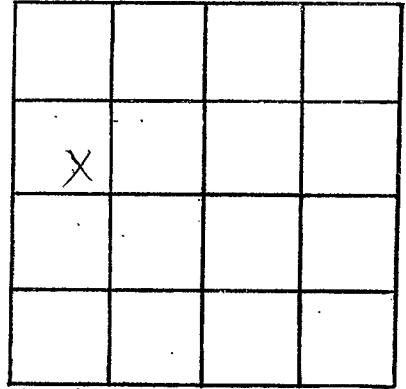

SECTION 23

Please indicate well location X.

ADDITIONAL INFORMATION

If more than one screen,  
show locations of each on sketch.