

TATE
B 209
8-24-78

**MISSISSIPPI
BOARD OF WATER COMMISSIONERS**
416 North State Street
Jackson, Mississippi 39201

WATER WELL DRILLERS LOG

8-24-78 19 Bob Smith Well Sv. Tate
 date well completed firm name county well located

LANDOWNER:
Eddie Reed
Coldwaters, Ms.
 (mailing address)

description of formations encountered	from to	
	ft	ft
top soil	0	5
red clay	5	60
sand	60	105

WELL LOCATION:
 sec. 2 T. 7 N. R. 2 E
4 miles NE of Coldwaters
 (distance) (direction) (nearest town)

WELL PURPOSE:
 (home) irrigation, municipal, industrial

WELL COMPLETION DATA:

(1) diameter (inches) 4"

(2) total depth (feet) 105

(3) static water level (feet) 30 below top of ground

(4) casing plastic 105
 (material) (depth)

(size) if telescope see back.

(5) screen 10 95
 (length) (depth to top)

4" plastic
 (size) (material)

(6) pump 3/4 10
 (HP) (yield gpm)

E see
 (type power)

(7) electric log (yes or no)

(organization running log)

(8) how well bottom plugged


DRILLERS REMARKS:

RECEIVED
 NOV 27 1978

MISS. BD. OF WATER COMMISSIONERS

If well telescopes please sketch and show depths.

GROUND LEVEL

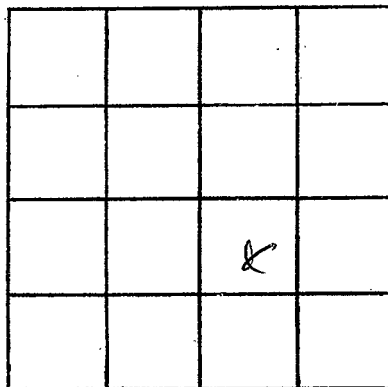

SECTION _____

Please indicate well location X.

ADDITIONAL INFORMATION

If more than one screen, show locations of each on sketch.