

TATE  
 B 2002  
 6-7-78

MISSISSIPPI  
 BOARD OF WATER COMMISSIONERS  
 416 North State Street  
 Jackson, Mississippi 39201

WATER WELL DRILLERS LOG

6-7-78 19 Bob Smith Well Serv Tate  
 date well completed firm name county well located

LANDOWNER:  
Francis Valente  
Calderate, Mo.  
 (mailing address)

description of formations encountered	from	to
<u>top soil</u>	<u>0</u>	<u>5</u>
<u>red clay</u>	<u>5</u>	<u>40</u>
<u>sand</u>	<u>40</u>	<u>105</u>

WELL LOCATION:  
 sec 26 T 4 N R 7 E  
6 miles E of Calderate  
 (distance) (direction) (nearest town)

WELL PURPOSE:  
 (home) irrigation, municipal, industrial

WELL COMPLETION DATA:

(1) diameter (inches) 4 1/2

(2) total depth (feet) 105

(3) static water level (feet) 50 below top of ground

(4) casing plastic, 105  
 (material) (depth)

(size) If telescope see back.

(5) screen 10, 95  
 (length) (depth to top)

4 1/2, plastic  
 (size) (material)

(6) pump 1/3, 5  
 (HP) (yield gpm)


Elec.  
 (type power)

(7) electric log (yes or no)

(organization running log)

(8) how well bottom plugged


DRILLERS REMARKS:

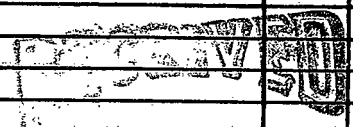

NOV 27 1978

If well telescopes please sketch and show depths.

GROUND LEVEL

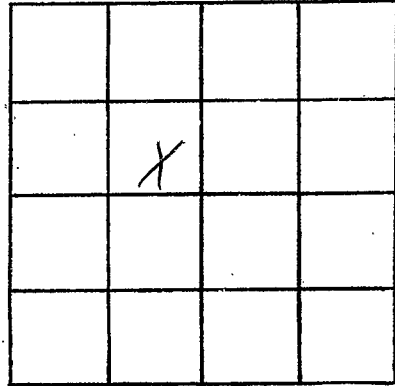

SECTION \_\_\_\_\_

Please indicate well location X.

ADDITIONAL INFORMATION

If more than one screen,  
show locations of each on sketch.