

TATE  
 B 2000  
 3-10-80

MISSISSIPPI  
 BOARD OF WATER COMMISSIONERS  
 416 North State Street  
 Jackson, Mississippi 39201

WATER WELL DRILLERS LOG

3/10/80 date well completed 19 BOB SMITH WELL SERVICE firm name TATE county well located

LANDOWNER:  
 Steve Johnson  
 Colquhoun, Mo.  
 (mailing address)

| description of formations encountered | from | to  |
|---------------------------------------|------|-----|
| top soil                              | 0    | 5   |
| red clay                              | 5    | 30  |
| gravel                                | 30   | 60  |
| bedrock sample                        | 60   | 165 |

WELL LOCATION:  
 sec. 35 T 4 N R 7 E  
 S W  
 6 miles NNE of Colquhoun  
 (distance) (direction) (nearest town)

WELL PURPOSE:  
 (home, irrigation, municipal, industrial)

- WELL COMPLETION DATA:
- (1) diameter (inches) 4"
  - (2) total depth (feet) 165
  - (3) static water level (feet) 100 below above top of ground.
  - (4) casing plastic, 100' (material) (depth)
  - \_\_\_\_\_ If telescope-see back. (size)
  - (5) screen 10' length, 165' depth to top. 4" plastic (size) (material)
  - (6) pump 1/2 (HP), 10 (yield gpm) elec (type power)
  - (7) electric log (yes or no)
  - \_\_\_\_\_ (organization running log)
  - (8) how well bottom plugged cap

DEPT. OF NATURAL RESOURCES  
 BUREAU OF LAND & WATER RESOURCES


OCT 15 1981

RECEIVED

DRILLERS REMARKS:

If well telescopes please sketch and show depths.

GROUND LEVEL

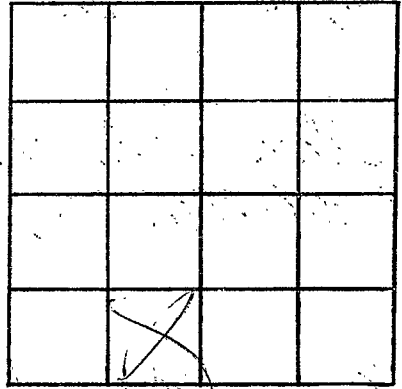

SECTION \_\_\_\_\_

Please indicate well location X.

ADDITIONAL INFORMATION

If more than one screen, show locations of each on sketch.