

MISSISSIPPI DEPARTMENT OF NATURAL RESOURCES

Bureau of Land and Water Resources

Southport Mall

P.O. Box 10631

Jackson, Mississippi 39209

WATER WELL DRILLERS LOG

TATE  
B 2031  
12-15-80

12-15-1980 date well completed      Links Well Co. firm name      Tate county well located

LANDOWNER: Malba B Young  
At. 2  
Caldwater, Mo. 38618  
(mailing address)

description of formations encountered	from	to
Red Clay	0	10
Clay + Sand	10	50
White Sand	50	128

WELL LOCATION:  
sec 23 T 4 N R 7 E  
5 miles NE of Caldwater  
(distance) (direction) (nearest town)

WELL PURPOSE: Home  
(home, irrigation, municipal, industrial)

WELL COMPLETION DATA:

(1) diameter (inches) 4

(2) total depth (feet) 128

(3) static water level (feet) 90 below above top of ground.

(4) casing PVC 128  
(material) (depth)

       if telescope see back.  
(size)

(5) screen 7 121  
(length) (depth to top)

02 Drum Taper  
(size) (material)

(6) pump 1/2 10  
(HP) (yield gpm)

220V  
(type power)

(7) electric log No  
(yes or no)

(organization running log)

(8) how well bottom plugged Cap

DRILLERS REMARKS:


MISSISSIPPI DEPARTMENT OF NATURAL RESOURCES  
BUREAU OF LAND AND WATER RESOURCES

JAN 12 1981

RECEIVED

If well telescopes please  
sketch and show depths.

GROUND LEVEL

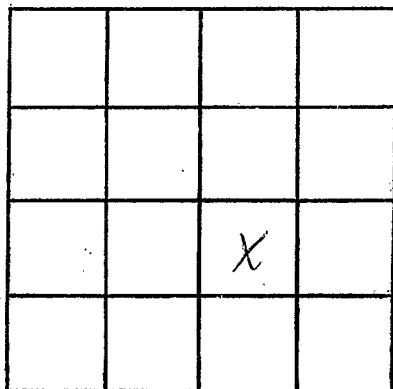

SECTION 23

Please indicate well location X.

ADDITIONAL INFORMATION

If more than one screen,  
show locations of each on sketch.