

MISSISSIPPI DEPARTMENT OF NATURAL RESOURCES

Bureau of Land and Water Resources

Southport Mall

P.O. Box 10631

Jackson, Mississippi 39209

WATER WELL DRILLERS LOG

TATE
B 2032
1-7-81

1-7 1981 Hiads Well Co. Tate
date well completed firm name county well located

LANDOWNER: Jack Hubbard
3053 Linda Dr.
Memphis, Tenn.
(mailing address)

description of formations encountered	from	to
	Red Clay	0
Clay + Sand	10	95
White Sand	95	140

WELL LOCATION:
sec. B3 T 4 N R 7 E
5 miles E of Collevate
(distance) (direction) (nearest town)

WELL PURPOSE: Home
(home, irrigation, municipal, industrial)

WELL COMPLETION DATA:

- (1) diameter (inches) 4
- (2) total depth (feet) 140
- (3) static water level (feet) 80 below above top of ground.
- (4) casing PVC, 140,
(material) (depth)
 If telescope see back.
(size)
- (5) screen 7, 133
(length) (depth to top)
4", gravel type
(size) (material)
- (6) pump 1/2, 10
(HP) (yield gpm)
220V
(type power)
- (7) electric log No
(yes or no)

(organization running log)
- (8) how well bottom plugged Cap

DRILLERS REMARKS:


DEPT. OF NATURAL RESOURCES
BUREAU OF LAND & WATER RESOURCES

FEB 12 1981

RECEIVED

If well telescopes please sketch and show depths.

GROUND LEVEL

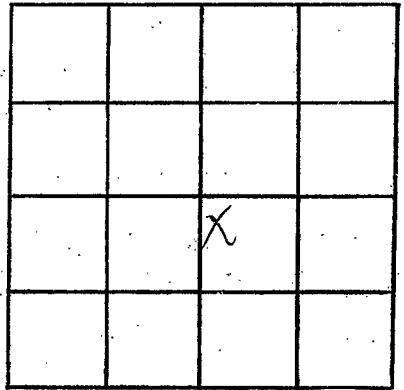

SECTION 23

Please indicate well location X.

ADDITIONAL INFORMATION

If more than one screen, show locations of each on sketch.