

MISSISSIPPI DEPARTMENT OF NATURAL RESOURCES

Bureau of Land and Water Resources

Southport Mall

P.O. Box 10631

Jackson, Mississippi 39209

WATER WELL DRILLERS LOG

Date
 B 2033
 8-26-81

HICKS WELL CO.

Rt. 1, Box 157

Senatobia, MS 38668

Tate

8-26 19 81
 date well completed

county well located


LANDOWNER:	description of formations encountered	from	to
Walter Simmons Rt. 2 Box 183 B Coldwater, Ms. (mailing address)	Red Clay	0	30
	Red Sand	30	70
	White Sand	70	130
WELL LOCATION: sec. 36 T 4 N R 7 E 3 miles NW of Poagville (distance) (direction) (nearest town)			
WELL PURPOSE: Home (home, irrigation, municipal, industrial)			
WELL COMPLETION DATA: (1) diameter (inches) 4 (2) total depth (feet) 130 (3) static water level (feet) 80 below top of ground. (4) casing PVC, 130, (material) (depth) (size) if telescope see back. (5) screen 7, 123 (length) (depth to top) 4" gravel type (size) (material) (6) pump 1/2, 10 (HP) (yield gpm) 220V (type power) (7) electric log No (yes or no) (organization running log) (8) how well bottom plugged CAP			
DRILLERS REMARKS:			

DEPT. OF NATURAL RESOURCES
 BUREAU OF LAND & WATER RESOURCES

SEP 24 1981
 RECEIVED

If well telescopes please sketch and show depths.

GROUND LEVEL

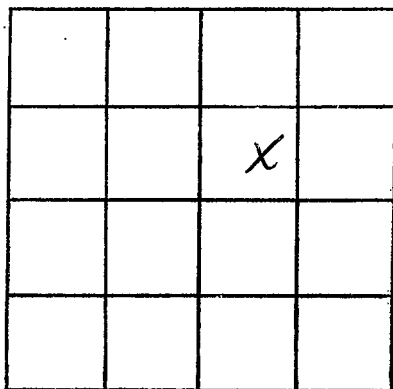

SECTION 36

Please indicate well location X.

ADDITIONAL INFORMATION

If more than one screen,
show locations of each on sketch.