

MISSISSIPPI DEPARTMENT OF NATURAL RESOURCES

Bureau of Land and Water Resources

Southport Mall

P.O. Box 10631

Jackson, Mississippi 39209

WATER WELL DRILLERS LOG

Late
B 2034
11-3-81

HICKS WELL COMPANY

Late

date well completed 11-3-81 firm name RT. 1 - BOX 157 county well located SENATODIA, MISS

LANDOWNER: Danny Western description of formations encountered

	from	to
<u>Red Clay</u>	<u>0</u>	<u>10</u>
<u>Gravel</u>	<u>10</u>	<u>35</u>
<u>White Clay & Red Sand</u>	<u>35</u>	<u>95</u>
<u>White Sand</u>	<u>95</u>	<u>140</u>

LANDOWNER: Danny Western
 (mailing address) Caldwater, Mo.

WELL LOCATION:
 sec. 32 T 4 N R 7 E
1/4 miles E of Caldwater
 (distance) (direction) (nearest town)

WELL PURPOSE: Home
 (home, irrigation, municipal, industrial)

WELL COMPLETION DATA:

- (1) diameter (inches) 4
- (2) total depth (feet) 140
- (3) static water level (feet) 60 below above top of ground.
- (4) casing PVC 140
 (material) (depth)
 (size) if telescope see back.
- (5) screen 7 133
 (length) (depth to top)
4" gravel & PVC
 (size) (material)
- (6) pump 1/2 10
 (HP) (yield gpm)
220V
 (type power)
- (7) electric log No
 (yes or no)
 (organization running log)
- (8) how well bottom plugged Cap

DRILLERS REMARKS:


DEPT. OF NATURAL RESOURCES
 BUREAU OF LAND & WATER RESOURCES

NOV 9 - 1981

RECEIVED

If well telescopes please sketch and show depths.

GROUND LEVEL

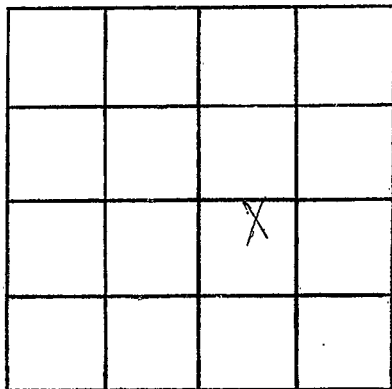

SECTION 32

Please indicate well location X.

ADDITIONAL INFORMATION

If more than one screen,
show locations of each on sketch.