

MISSISSIPPI DEPARTMENT OF NATURAL RESOURCES

Bureau of Land and Water Resources

Southport Mall

P.O. Box 10631

Jackson, Mississippi 39209

WATER WELL DRILLERS LOG

TATE
B 2035
11-4-81

11-4 1981 HICKS WELL COMPANY Tate  
 date well completed notifying agency county well located

LANDOWNER: <u>Sidney Malone</u>	description of formations encountered	from	to
<u>Rt. 3 Box 319</u>			
<u>Caldwate, Mo.</u> (mailing address) <u>38618</u>	<u>White Sand</u>	<u>50</u>	<u>110</u>
<b>WELL LOCATION:</b>			
sec. <u>23</u> T <u>4</u> N R <u>7</u> E			
<u>4</u> miles <u>NE</u> of <u>Caldwate</u>			
(distance) (direction) (nearest town)			
<b>WELL PURPOSE:</b> <u>Home</u> (home, irrigation, municipal, industrial)			
<b>WELL COMPLETION DATA:</b>			
(1) diameter (inches) <u>4</u>			
(2) total depth (feet) <u>110</u>			
(3) static water level (feet) <u>60</u> below above top of ground.			
(4) casing <u>PK</u> <u>110</u> (material) (depth)			
<u>      </u> if telescope see back. (size)			
(5) screen <u>7</u> <u>103</u> (length) (depth to top)			
<u>4"</u> <u>gravel + PK</u> (size) (material)			
(6) pump <u>1/2</u> <u>10</u> (HP) (yield gpm)			
<u>220V</u> (type power)			
(7) electric log <u>No</u> (yes or no)			
<u>      </u> (organization running log)			
(8) how well bottom plugged <u>Cap</u>			

DRILLERS REMARKS:


DEPT. OF NATURAL RESOURCES  
 BUREAU OF LAND & WATER RESOURCES

NOV 30 1981

RECEIVED

If well telescopes please sketch and show depths.

GROUND LEVEL

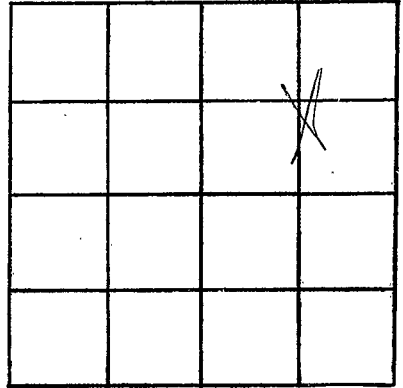

SECTION 23

Please indicate well location X.

ADDITIONAL INFORMATION

If more than one screen,  
show locations of each on sketch.