

MISSISSIPPI DEPARTMENT OF NATURAL RESOURCES

Bureau of Land and Water Resources

Southport Mall

P.O. Box 10631

Jackson, Mississippi 39209

WATER WELL DRILLERS LOG

TATE
B 2036
12/11/81

Tate

12-11-81

HICKS WELL COMPANY

date well completed

1 - BOX #157 name

county well located

LANDOWNER: Mamie Frost
Box 3
Coldwater, Ms. 38618
 (mailing address)

description of formations encountered	from	to
<u>Red sand</u>	<u>0</u>	<u>50</u>
<u>Whit sand</u>	<u>50</u>	<u>125</u>

WELL LOCATION:
 sec 23 T 4 N R 2 E
4 miles NE of Coldwater
 (distance) (direction) (nearest town)

WELL PURPOSE: Home
 (home, irrigation, municipal, industrial)

WELL COMPLETION DATA:

(1) diameter (inches) 4

(2) total depth (feet) 125

(3) static water level (feet) 60 below above top of ground.

(4) casing PVC, 125
 (material) (depth)

 if telescope see back.
 (size)

(5) screen 2x, 118
 (length) (depth to top)

4", spaced PVC
 (size) (material)

(6) pump 1/2 10
 (HP) (yield gpm)

220V
 (type power)

(7) electric log No
 (yes or no)

(organization running log)


(8) how well bottom plugged Cap

DRILLERS REMARKS:

DEPT. OF NATURAL RESOURCES
 BUREAU OF LAND & WATER RESOURCES
 JAN 4 1982
RECEIVED

If well telescopes please sketch and show depths.

GROUND LEVEL

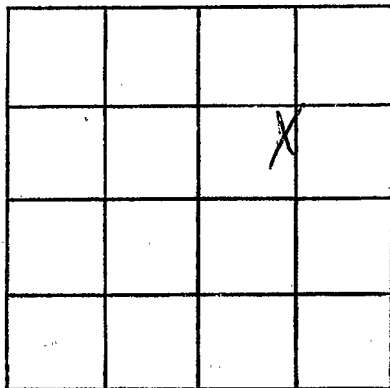

SECTION 23

Please indicate well location X.

ADDITIONAL INFORMATION

If more than one screen,
show locations of each on sketch.