

MISSISSIPPI DEPARTMENT OF NATURAL RESOURCES

Bureau of Land and Water Resources

Southport Mall

P.O. Box 10631

Jackson, Mississippi 39209

WATER WELL DRILLERS LOG

Date
B2057

HICKS WELL COMPANY

John

5-5 1982 date well completed
 1-BOX 157 firm name
 county well located

LANDOWNER: Jimmy Traywick Rt. 4 Box T90 Coldwater, Miss (mailing address) 38618	description of formations encountered	from	to
	Red Clay	0	10
	Red Sand	10	35
	Gravel	35	38
	White Sand + Clay	38	140
	White Sand	140	170

WELL LOCATION:
 sec. 32 T 4 N R 7 E
 1/2 miles E of Coldwater
 (distance) (direction) (nearest town)

WELL PURPOSE: Home
 (home, irrigation, municipal, industrial)

WELL COMPLETION DATA:

(1) diameter (inches) 4

(2) total depth (feet) 185

(3) static water level (feet) 60 below above top of ground.

(4) casing PVC, 185.
 (material) (depth)

(size) If telescope see back.

(5) screen 10, 175
 (length) (depth to top)

1/2, PVC
 (size) (material)

(6) pump 1/2, 10
 (HP) (yield gpm)

220V
 (type power)

(7) electric log No
 (yes or no)

(organization running log) Cap

(8) how well bottom plugged

DRILLERS REMARKS:


DEPT. OF NATURAL RESOURCES
 BUREAU OF LAND & WATER RESOURCES

MAY 10 1982

RECEIVED

If well telescopes please sketch and show depths.

GROUND LEVEL

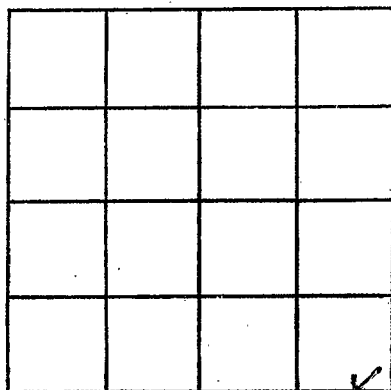

SECTION 32

Please indicate well location X.

ADDITIONAL INFORMATION

If more than one screen,
show locations of each on sketch.