

MISSISSIPPI DEPARTMENT OF NATURAL RESOURCES

Bureau of Land and Water Resources

Southport Mall

P.O. Box 10631

Jackson, Mississippi 39209

WATER WELL DRILLERS LOG

Date
B 2005

6-20-82 19 Bob Smith Jate
date well completed firm name county well located

LANDOWNER:	description of formations encountered	from	to
<u>J. B. Dondridge</u>	<u>top soil</u>	<u>0</u>	<u>5</u>
<u>Coldwater, Miss</u>	<u>red clay</u>	<u>5</u>	<u>30</u>
(mailing address)	<u>granite</u>	<u>30</u>	<u>70</u>
	<u>sand</u>	<u>70</u>	<u>155</u>

WELL LOCATION:
sec 32 T 4 N R 7 E
(S) (W)
0 miles of Coldwater
(distance) (direction) (nearest town)

WELL PURPOSE:
(home, irrigation, municipal, industrial)

- WELL COMPLETION DATA:
- (1) diameter (inches) 4"
 - (2) total depth (feet) 155'
 - (3) static water level (feet) 55 below above top of ground.
 - (4) casing plastic 155'
(material) (depth)
 - _____ if telescope see back.
(size)
 - (5) screen 20 135'
(length) (depth to top)
 - 4" plastic
(size) (material)
 - (6) pump 1/2 10
(HP) (yield gpm)
 - elec.
(type power)
 - (7) electric log (yes) (no)
 - _____ (organization running log)
 - (8) how well bottom plugged Cap

DRILLERS REMARKS:


DEPT. OF NATURAL RESOURCES
BUREAU OF LAND & WATER RESOURCES

OCT 12 1982

RECEIVED

If well telescopes please sketch and show depths.

GROUND LEVEL

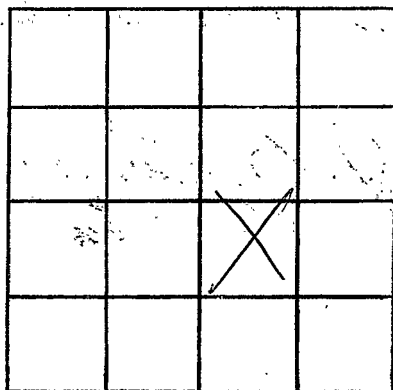

SECTION _____

Please indicate well location X.

ADDITIONAL INFORMATION

If more than one screen, show locations of each on sketch.