

MISSISSIPPI DEPARTMENT OF NATURAL RESOURCES

Bureau of Land and Water Resources

Southport Mall

P.O. Box 10631

Jackson, Mississippi 39209

WATER WELL DRILLERS LOG

Date
Book

3-24 1983 Gullett Well Drilling Tate
 date well completed firm name county well located

LANDOWNER: Palestine Meth Church

description of formations encountered	from	to
top soil	0	5
red clay	5	25
sand and clay	25	185

Coldwater, Ms
 (mailing address)

WELL LOCATION:
 sec. 12-4 R 7 E S
 5 miles Northwest of Coldwater
 (distance) (direction) (nearest town)

WELL PURPOSE:
 (home, irrigation, municipal, industrial)

WELL COMPLETION DATA:

- (1) diameter (inches) 4"
- (2) total depth (feet) 120'
- (3) static water level (feet) 85' below top of ground.
- (4) casing 160 PVC, 120' (material) (depth)
 4" (size) if telescope see back.
- (5) screen 10 (length) (depth to top)
 4" (size) 160 PVC (material)
- (6) pump 1/2 (HP) 10 (yield gpm)
 electric (type power)
- (7) electric log (yes or no)
 (organization running log)
- (8) how well bottom plugged Cap

DRILLERS REMARKS:


DEPT. OF NATURAL RESOURCES
 BUREAU OF LAND & WATER RESOURCES

JUN 21 1983

RECEIVED

If well telescopes please
sketch and show depths.

GROUND LEVEL

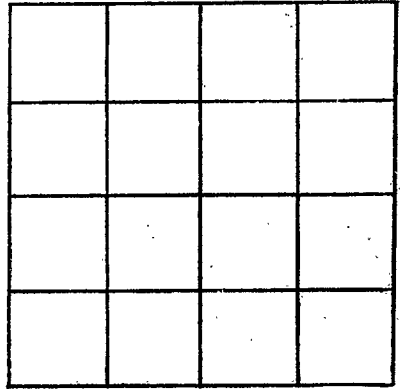

SECTION _____

Please indicate well location X.

ADDITIONAL INFORMATION

If more than one screen,
show locations of each on sketch.