

MISSISSIPPI DEPARTMENT OF NATURAL RESOURCES

Bureau of Land and Water Resources

Southport Mall

P.O. Box 10631

Jackson, Mississippi 39209

WATER WELL DRILLERS LOG

Date  
 B 2044

6-21 1983  
 date well completed

HICKS WELL CO.  
 No. 2 firm name  
 Senatobia, MS 38660

Tate  
 county well located

LANDOWNER: Rodgers Funeral Home  
P.O. Box 490  
Caldwate, Miss. 38618  
 (mailing address)

description of formations encountered

from to

Red Clay	0	15
Red Sand	15	90
White Sand	90	105

WELL LOCATION:  
 sec. 30 T 4 N R 7 E  
 (distance) miles (direction) of Caldwate  
 (nearest town)

WELL PURPOSE: Funeral Home  
 (home, irrigation, municipal, industrial)

WELL COMPLETION DATA:

- (1) diameter (inches) 4
- (2) total depth (feet) 105
- (3) static water level (feet) 20 ~~below~~ above top of ground.
- (4) casing PVC, 105,  
 (material) (depth)  
4"  
 (size) if telescope see back.
- (5) screen 10', 95'  
 (length) (depth to top)  
.013, PVC  
 (size) (material)
- (6) pump 1/2, 10  
 (HP) (yield gpm)  
220V  
 (type power)
- (7) electric log No  
 (yes or no)  
 (organization running log)
- (8) how well bottom plugged CRP

DEPT. OF NATURAL RESOURCES  
 BUREAU OF LAND & WATER RESOURCES


AUG 11 1983

RECEIVED

DRILLERS REMARKS:

If well telescopes please sketch and show depths.

GROUND LEVEL

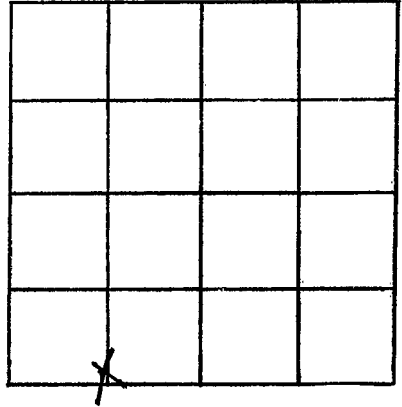

SECTION 30

Please indicate well location X.

ADDITIONAL INFORMATION

If more than one screen,  
show locations of each on sketch.