

MISSISSIPPI DEPARTMENT OF NATURAL RESOURCES

Bureau of Land and Water Resources

Southport Mall

P.O. Box 10631

Jackson, Mississippi 39209

WATER WELL DRILLERS LOG

Date
B
2044

2-25 1983  
date well completed

Gullett Well Drilling  
firm name

Tate  
county well located

LANDOWNER: <u>Charles Plumber</u>	description of formations encountered	from	to
<u>Palestine Rd.</u>			
<u>Coldwater Ms</u> (mailing address)	<u>top soil</u>	<u>0</u>	<u>5</u>
WELL LOCATION: sec. <u>12 T. 4 N. 5 S.</u> R. <u>7 E.</u>	<u>red clay</u>	<u>5</u>	<u>40</u>
<u>10</u> miles <u>East</u> of <u>Coldwater</u> (distance) (direction) (nearest town)	<u>Sand</u>	<u>40</u>	<u>130</u>
WELL PURPOSE: <u>home</u> (home, irrigation, municipal, industrial)			
WELL COMPLETION DATA:			
(1) diameter (inches) <u>4"</u>			
(2) total depth (feet) <u>130'</u>			
(3) static water level (feet) _____ below above top of ground.			
(4) casing <u>1 1/2" PVC</u> , <u>130'</u> (material) (depth)			
_____ if telescope see back. (size)			
(5) screen <u>10'</u> , <u>120'</u> (length) (depth to top)			
<u>1 1/2"</u> , <u>1 1/2" PVC</u> (size) (material)			
(6) pump <u>1/2</u> , <u>10</u> (HP) (yield gpm)			
<u>elec</u> (type power)			
(7) electric log <u>No</u> (yes or no)			
_____ (organization running log)			
(8) how well bottom plugged <u>Cap</u>			
DRILLERS REMARKS:			


DEPT. OF NATURAL RESOURCES  
BUREAU OF LAND & WATER RESOURCES

DEC - 7 1983

RECEIVED

If well telescopes please sketch and show depths.

GROUND LEVEL

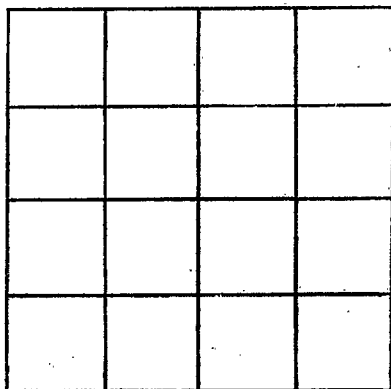

SECTION \_\_\_\_\_

Please indicate well location X.

ADDITIONAL INFORMATION

If more than one screen,  
show locations of each on sketch.