

MISSISSIPPI DEPARTMENT OF NATURAL RESOURCES

Bureau of Land and Water Resources

Southport Mall

P.O. Box 10631

Jackson, Mississippi 39209

WATER WELL-DRILLERS LOG

HICKS WELL CO.  
Rt. 1, Box 157

Senatobia, Miss. 38668

Date  
B 2045

10/26 1983  
date well completed

Tate  
county well located

LANDOWNER: John Sypp  
Rt. 2

description of formations encountered from to

Caldwater, Miss.  
(mailing address) 38618

Red Clay 0 20  
White Clay 20 50

WELL LOCATION:  
sec. 32 T. 4 N. R. 2 E.  
1/4 miles E of Caldwater  
(distance) (direction) (nearest town)

Gravel 50 65  
White Sand 65 125

WELL PURPOSE: Home  
(home, irrigation, municipal, industrial)

WELL COMPLETION DATA:

- (1) diameter (inches) 4
- (2) total depth (feet) 125
- (3) static water level (feet) 60 <sup>below</sup> <sub>above</sub> top of ground.
- (4) casing PVC, 125' (material) (depth)  
4" If telescope see back. (size)
- (5) screen 10' length, 115' depth to top  
1013 PVC (size) (material)
- (6) pump 1/2 HP, 10 yield gpm  
220V (type power)
- (7) electric log No (yes or no)

(organization running log)

(8) how well bottom plugged Cap

DRILLERS REMARKS:


DEPT. OF NATURAL RESOURCES  
BUREAU OF LAND & WATER RESOURCES

JAN 9 - 1984

RECEIVED

If well telescopes please sketch and show depths.

GROUND LEVEL

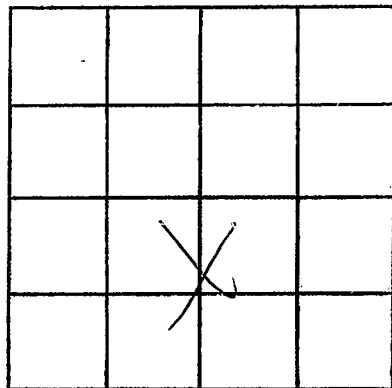

SECTION 32

Please indicate well location X.

ADDITIONAL INFORMATION

If more than one screen,  
show locations of each on sketch.