

MISSISSIPPI DEPARTMENT OF NATURAL RESOURCES

Bureau of Land and Water Resources

Southport Mall

P.O. Box 10631

Jackson, Mississippi 39209

WATER WELL DRILLERS LOG

Tate
Boyer
3-30-85

3-30 19 85
date well completed

HICKS WELL CO.
firm name
Senatobia MS 38688

Tate
county well located

LANDOWNER: Katie Nolan

description of formations encountered	from	to
	Red clay	0
Red Sand & gravel	10	30
White Sand	30	125

Coldwater MS 38878
(mailing address)

WELL LOCATION:

sec. 32 T 4 N R 7 E
S W
_____ miles _____ of Coldwater
(distance) (direction) (nearest town)

WELL PURPOSE: Home
(home, irrigation, municipal, industrial)

WELL COMPLETION DATA:

- (1) diameter (inches) 4"
- (2) total depth (feet) 125'
- (3) static water level (feet) 60' (below/above top of ground)
- (4) casing PVC, 115',
(material) (depth)
4" if telescope see back.
(size)
- (5) screen 10', 115'
(length) (depth to top)
1/2", PVC
(size) (material)
- (6) pump 1/2 10
(HP) (yield gpm)
220 Electric
(type power)
- (7) electric log NO
(yes or no)

(organization running log)

(8) how well bottom plugged Cap


DRILLERS REMARKS:

RECEIVED
JUL 1 - 1985

Department of Natural Resources
Bureau of Land & Water Resources

If well telescopes please sketch and show depths.

GROUND LEVEL

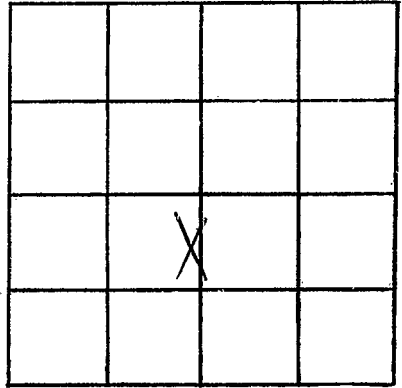

SECTION 32

Please indicate well location X.

ADDITIONAL INFORMATION

If more than one screen,
show locations of each on sketch.