

MISSISSIPPI DEPARTMENT OF NATURAL RESOURCES

Bureau of Land and Water Resources

Southport Mall

P.O. Box 10631

Jackson, Mississippi 39209

WATER WELL DRILLERS LOG

NICKS WELL CO.
Box 157

firm no. 38668

Tate
B 2049
4-10-85

4-10-85
date well completed

TATE
county well located

LANDOWNER: STERLIN EASLEY
RT-4 COLDWATER
MS. 38618
(mailing address)

| description of formations encountered | from | to |
|---------------------------------------|------|-----|
| Red CLAY | 0 | 10 |
| CLAY + SAND | 10 | 30 |
| WHITE SAND | 30 | 125 |

WELL LOCATION:
sec. 35 T 4 N R 7 E
5 miles EAST of Coldwater
(distance) (direction) (nearest town)

WELL PURPOSE: home
(home, irrigation, municipal, industrial)

- WELL COMPLETION DATA:
- (1) diameter (inches) 4"
 - (2) total depth (feet) 125'
 - (3) static water level (feet) 80' ^{below} _{above} top of ground.
 - (4) casing PVC, 115',
(material) (depth)
4"
(size) if telescope see back.
 - (5) screen 10', 125'
(length) (depth to top)
2 1/2", PVC
(size) (material)
 - (6) pump 1/2, 10
(HP) (yield gpm)
220 Elec
(type power)
 - (7) electric log No
(yes or no)
(organization running log)
 - (8) how well bottom plugged CAP


RECEIVED
JUL 1 - 1985

Department of Natural Resources
Bureau of Land & Water Resources

DRILLERS REMARKS:

If well telescopes please sketch and show depths.

GROUND LEVEL

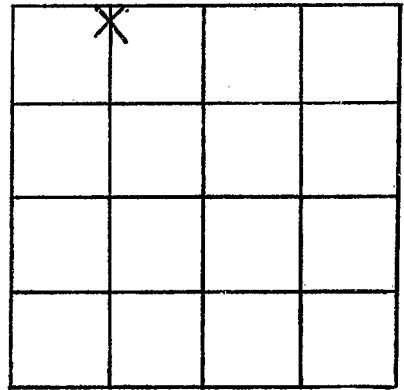

SECTION 35

Please indicate well location X.

ADDITIONAL INFORMATION

If more than one screen,
show locations of each on sketch.