

MISSISSIPPI DEPARTMENT OF NATURAL RESOURCES

Bureau of Land and Water Resources

Southport Mall

P.O. Box 10631

Jackson, Mississippi 39209

WATER WELL DRILLERS LOG

HICKS WELL COMPANY

DATE
B 2050

date well completed 9-25 1985

RT. 1 - Box 157
Driller name

Date
county well located

SENATOBIA, MISS.

LANDOWNER: William Bryant

description of formations encountered

from to

P.O. Box 272

Red clay

0 10

Caldwell, MS 38818
(mailing address)

Gravel & red sand

10 30

WELL LOCATION:

sec. 35 T 4 N R 8 E
S W
3 miles W of Caldwell
(distance) (direction) (nearest town)

White sand

30 125

WELL PURPOSE: None
(home, irrigation, municipal, industrial)


WELL COMPLETION DATA:

- (1) diameter (inches) 4"
- (2) total depth (feet) 125'
- (3) static water level (feet) 60 below above top of ground.
- (4) casing PVC, 115' (material) (depth)
4" (size) if telescope see back.
- (5) screen 10' 115' (length) (depth to top)
.013 PVC (size) (material)
- (6) pump 1 hp 18 (HP) (yield gpm)
2700 (type power)
- (7) electric log NO (yes or no)

(organization running log)

(8) how well bottom plugged Cap


DRILLERS REMARKS:

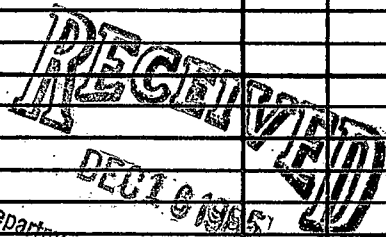

Department of Natural Resources
Bureau of Land & Water Resources

If well telescopes please sketch and show depths.

GROUND LEVEL

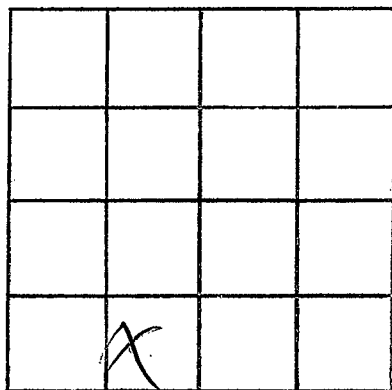

SECTION 35

Please indicate well location X.

ADDITIONAL INFORMATION

If more than one screen,
show locations of each on sketch.