

MISSISSIPPI DEPARTMENT OF NATURAL RESOURCES

Bureau of Land and Water Resources

Southport Mall

P.O. Box 10631

Jackson, Mississippi 39209

WATER WELL DRILLERS LOG

HICKS WELL COMPANY

TITLE
B2051

3-14 1986
date well completed

RT. 1 - firm name

Date
county well located

LANDOWNER:	description of formations encountered	from	to
Conley Jones RT # 1	Red clay	0	10
Senatobia MS 38668 (mailing address)	Red sand	10	30
WELL LOCATION: sec. 12 T 46 N R 7 E S W	Clay & gravel	30	90
1 miles N of Grand Springs (distance) (direction) (nearest town)	white sand	90	155
WELL PURPOSE: (home, irrigation, municipal, industrial)			
WELL COMPLETION DATA:			
(1) diameter (inches) 4"			
(2) total depth (feet) 155'			
(3) static water level (feet) 90' below top of ground.			
(4) casing PVC, 145' (material) (depth)			
1/2" If telescope see back. (size)			
(5) screen 10', 145' (length) (depth to top)			
013 PVC (size) (material)			
(6) pump 1/2 HP 10 (HP) (yield gpm)			
220V (type power)			
(7) electric log No (yes or no)			
(organization running log)			
(8) how well bottom plugged Cap			

RECEIVED


MAY 19 1986

Department of Natural Resources
Bureau of Land & Water Resources

DRILLERS REMARKS:

If well telescopes please sketch and show depths.

GROUND LEVEL

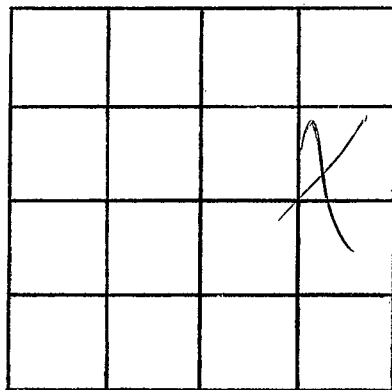

SECTION 12

Please indicate well location X.

ADDITIONAL INFORMATION

If more than one screen,
show locations of each on sketch.