

MISSISSIPPI DEPARTMENT OF NATURAL RESOURCES
Bureau of Land and Water Resources
 Southport Mall
 P.O. Box 10631
 Jackson, Mississippi 39209
WATER WELL DRILLERS LOG

TATE
B 2254

4-7 1987 LIPE WELL & SUPPLY TATE CO.
 date well completed firm name county well located

LANDOWNER: W.F. DAVIS
Box 124
COLDWATER, MS
 (mailing address)


WELL LOCATION:
 sec. 33 T. 9 S. R. 9 W.
5 miles W of COLDWATER
 (distance) (direction) (nearest town)

WELL PURPOSE: HOME
 (home, irrigation, municipal, industrial)

- WELL COMPLETION DATA:
- diameter (inches) 4
 - total depth (feet) 151
 - static water level (feet) 25 below above top of ground.
 - casing PVC, 140,
 (material) (depth)
 if telescope see back.
 (size)
 - screen 10, 140
 (length) (depth to top)
4, PVC/GRAVEL ROCK
 (size) (material)
 - pump 3/4, 10
 (HP) (yield gpm)
230V 1P
 (type power)
 - electric log NO
 (yes or no)

 (organization running log)
 - how well bottom plugged CAP

description of formations encountered	from	to
TOP SOIL	0	5
CLAY & SAND ROCK	5	20
CLAY	20	30
SAND W/CLAY	30	40
SAND	40	60
SAND	60	70
CLAY	70	80
CLAY	80	90
SAND	90	100
SAND	100	120
SAND	120	140
SAND	140	160

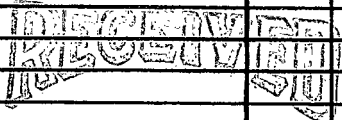


JAN 19 1988

Department of Natural Resources
 Bureau of Land & Water Resources

DRILLERS REMARKS:

If well telescopes please sketch and show depths.

GROUND LEVEL

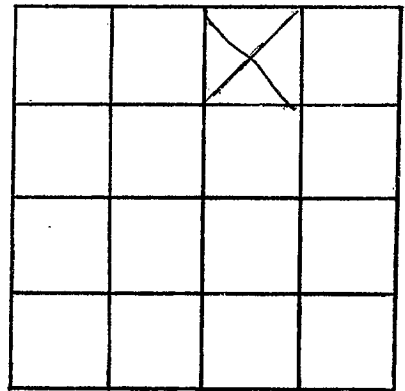

SECTION _____

Please indicate well location X.

ADDITIONAL INFORMATION

A series of horizontal lines for writing additional information.

If more than one screen, show locations of each on sketch.