

**MISSISSIPPI DEPARTMENT OF NATURAL RESOURCES**  
**Bureau of Land and Water Resources**  
 Southport Mall  
 P.O. Box 10631  
 Jackson, Mississippi 39209  
**WATER WELL DRILLERS LOG**

TATE  
B 2064

6-25 1990 LIPE WELL + Supply TATE  
 date well completed firm name county well located

LANDOWNER: <u>THOMAS YARBRO</u> <u>722 Powell St.</u>	description of formations encountered	from	to
<u>Coldwater, MS.</u> (mailing address)	<u>Top Soil</u>	<u>0</u>	<u>20</u>
	<u>CLAY</u>	<u>20</u>	<u>25</u>
	<u>FINE SAND</u>	<u>25</u>	<u>40</u>
	<u>FINE SAND</u>	<u>40</u>	<u>60</u>
<b>WELL LOCATION:</b>	<u>COARSE SAND</u>	<u>60</u>	<u>80</u>
sec. <u>33</u> T. <u>4</u> N. R. <u>8</u> E.	<u>COARSE SAND</u>	<u>80</u>	<u>100</u>
<u>5</u> miles <u>WEST</u> of <u>Coldwater</u>	<u>COARSE SAND</u>	<u>100</u>	<u>120</u>
(distance) (direction) (nearest town)	<u>COARSE SAND</u>	<u>120</u>	<u>140</u>
<b>WELL PURPOSE:</b> <u>Home</u> (home, irrigation, municipal, industrial)			
<b>WELL COMPLETION DATA:</b>			
(1) diameter (inches) <u>4</u>			
(2) total depth (feet) <u>140</u>			
(3) static water level (feet) _____ below top of ground. above			
(4) casing <u>PVC</u> , <u>130</u> , (material) (depth)			
_____ if telescope see back. (size)			
(5) screen <u>10</u> , <u>130</u> (length) (depth to top)			
<u>4</u> , <u>PVC</u> (size) (material)			
(6) pump <u>3/4</u> _____ (HP) (yield gpm)			
<u>electric</u> (type power)			
(7) electric log _____ (yes or no)			
_____ (organization running log)			
(8) how well bottom plugged <u>CAP</u>			
<b>DRILLERS REMARKS:</b>			


**RECEIVED**

AUG 15 1990

Department of Natural Resources  
 Bureau of Land & Water Resources

If well telescopes please sketch and show depths.

GROUND LEVEL

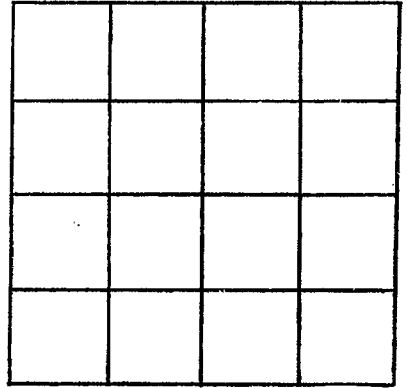

SECTION \_\_\_\_\_

Please indicate well location X.

ADDITIONAL INFORMATION

If more than one screen, show locations of each on sketch.