

MISSISSIPPI DEPARTMENT OF NATURAL RESOURCES  
 Bureau of Land and Water Resources  
 Southport Mall  
 P.O. Box 10631

Jackson, Mississippi 39209  
 WATER WELL DRILLERS LOG

Date  
AB 2075  
10-29-81

10-29-81 19 Bob Smith Jate  
 date well completed firm name county well located

LANDOWNER: Mid-West  
Church of Christ  
Arkabutla, Miss.  
 (mailing address)

description of formations encountered	from to	
	feet	feet
<u>top soil</u>	<u>0</u>	<u>5</u>
<u>red clay</u>	<u>5</u>	<u>20</u>
<u>gravel</u>	<u>30</u>	<u>70</u>
<u>white clay</u>	<u>70</u>	<u>180</u>
<u>sand</u>	<u>180</u>	<u>195</u>

WELL LOCATION:  
 sec. 31 T 4 N R 8 E  
4 miles EAST of Arkabutla  
 (distance) (direction) (nearest town)

WELL PURPOSE:  
 (home, irrigation, municipal, industrial)  
(home)

- WELL COMPLETION DATA:
- (1) diameter (inches) 4"
  - (2) total depth (feet) 195'
  - (3) static water level (feet) 135'  below  above top of ground.
  - (4) casing plastic, 195'  
 (material) (depth)  
 \_\_\_\_\_ if telescope see back.  
 (size)
  - (5) screen 20', 175'  
 (length) (depth to top)  
4", plastic  
 (size) (material)
  - (6) pump 1/2 10  
 (HP) (yield gpm)  
elec.  
 (type power)
  - (7) electric log no  
 (yes or no)  
 \_\_\_\_\_  
 (organization running log)
  - (8) how well bottom plugged Comp

DRILLERS REMARKS:  
 \_\_\_\_\_  
 \_\_\_\_\_  
 \_\_\_\_\_


DEPT. OF NATURAL RESOURCES  
 BUREAU OF LAND & WATER RESOURCES

SEP - 7 1982

RECEIVED

If well telescopes please sketch and show depths.

GROUND LEVEL

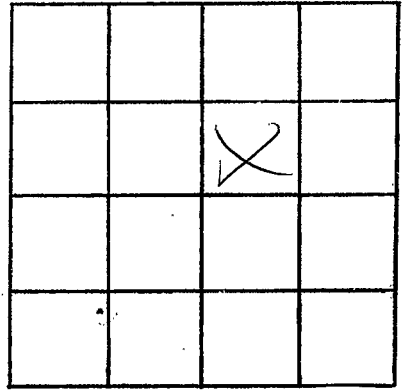

SECTION \_\_\_\_\_

Please indicate well location X.

ADDITIONAL INFORMATION

If more than one screen,  
show locations of each on sketch.