

MISSISSIPPI DEPARTMENT OF ENVIRONMENTAL QUALITY

Office of Land and Water Resources

P. O. Box 10631
Jackson, MS 39289-0631

WATER WELL DRILLERS LOG

COUNTY WELL LOCATED TATE	
WELL NUMBER B 2076	CODED
DATE WELL COMPLETED 12-30-97	

HICK WATER WELL CO.	
30242 HWY. 4 EAST	
SENATOBIA, MS 38668	

NAME & MAILING ADDRESS OF LANDOWNER Guyton Nunnally		
3200 Hwy 306		
Caldwater, MS 38618		
WELL LOCATION: SEC	TOWNSHIP	RANGE
34	4	7
	N S	E W
DISTANCE	DIRECTION	NEAREST TOWN
2 1/2 Miles	E	Caldwater
OTHER LANDMARK Ben Wynn Curve		
WELL PURPOSE: Home, Irrigation, Municipal, Industrial, Fish Pond, etc.		

PUMP DATA		
PUMP TYPE (Circle One): Submersible Turbine, Jet, Flowing Well, Other (Describe) _____		
POWER TYPE (Circle One): Electric Tractor, Diesel, Gasoline, Butane, Other (Describe) _____ H/P 1/2		
Pump Capacity (GPM)	No. of Stages	Setting Depth
12		120 FT.
PUMP TEST		
Well yielded _____ GPM with a drawdown of Test ft. after _____ hours of pumping		

WELL DATA		
Well Depth 160	Casing Diameter (In.) 4	Casing Length (Ft.) 150
Type of Casing PVC	Hole Depth 160	Depth to Static Water Level 90

LOG DATA	
TYPE OF LOG RUN (Circle One): No Log Run , Electric, Gamma Ray, Density, Sonic, Neutron, Other (Describe) _____	
Name of Organization Running Log	

TYPE OF COMPLETION: (Circle One or More): Gravel Packed , Underrreamed, Telescoped, Natural Development, Open Hole, Other (Describe) _____			
--	--	--	--

WELL GROUTED TO A DEPTH OF 3 FEET Type Grout (circle one): Cement , Bentonite, or Mix
--

GEOLOGIC DATA (Office Use Only)			
Surface Elev.	Geologic Unit	Unit Thickness	Depth to Top
Subs. SWL	Date	Analysis	Aquifer Test
Driller's Remarks			
Top of Lap Pipe or Reduction in Casing			
FEET		IF TELESCOPED OR MORE THAN ONE SCREEN: USE BACK PAGE	


SCREEN DATA		
Diameter - Inches 4	Length - Feet 10	Slot Size - Inches .013
Screen Type PVC Slot	Depth to Bottom - Feet 150	

DESCRIPTION OF FORMATIONS ENCOUNTERED	FROM	TO
Red Clay	0	10
Red Sand	10	60
White Sand	60	160

FORMATIONS (Continued)		FROM	TO
RECEIVED			
JAN 06 1998			
Dept. of Environmental Quality Office of Land & Water Resources			
IF MORE SPACE IS NEEDED, USE BACK			

If well telescopes please
sketch and show depths.

GROUND LEVEL

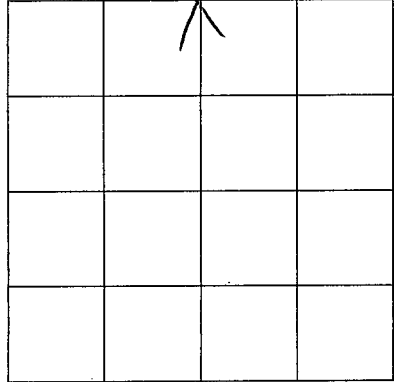

SECTION

34

Please indicate well location X.

ADDITIONAL INFORMATION

If more than one screen,
show location of each on sketch.