

**MISSISSIPPI DEPARTMENT OF ENVIRONMENTAL QUALITY**  
Office of Land and Water Resources

P. O. Box 10631  
Jackson, MS 39289-0631  
**WATER WELL DRILLERS LOG**

COUNTY WELL LOCATED <b>TATE</b>
WELL NUMBER CODED <b>B 2078</b>
DATE WELL COMPLETED <b>3-10-99</b>

PERMIT NUMBER
NAME OF DRILLING FIRM <b>HICKS WELL CO.</b>

NAME & MAILING ADDRESS OF LANDOWNER <b>LORENZO or SITA Lipford</b> <b>65 ANDERSON CR.</b> <b>Coldwater, MS 38618</b>		
WELL LOCATION: SEC	TOWNSHIP	RANGE
<b>32</b>	<b>4</b>	<b>7</b>
DISTANCE DIRECTION NEAREST TOWN <b>1/2</b> Miles <b>E</b> of <b>Coldwater</b>		
OTHER LANDMARK		
WELL PURPOSE: Home, Irrigation, Municipal, Industrial, Fish Pond, etc.		

<b>PUMP DATA</b>			
PUMP TYPE (Circle One): <del>Submersible</del> Turbine, Jet, Flowing Well, Other (Describe) _____			
POWER TYPE (Circle One): <del>Electric</del> Tractor, Diesel, Gasoline, <b>1/2</b> Butane, Other (Describe) _____ H/P _____			
Pump Capacity (GPM) <b>10</b>	No. of Stages	Setting Depth <b>80</b>	FT.
PUMP TEST			
Well yielded _____ GPM with a drawdown of <b>7</b> ft. after _____ hours of pumping			

<b>WELL DATA</b>		
Well Depth <b>142</b>	Casing Diameter (In.) <b>4</b>	Casing Length (Ft.) <b>132</b>
Type of Casing <b>PVC</b>	Hole Depth <b>142</b>	Depth to Static Water Level <b>55</b>

<b>LOG DATA</b>	
TYPE OF LOG RUN (Circle One): Electric, Gamma Ray, Density, Sonic, <b>No Log Run</b> , Neutron, Other (Describe) _____	
Name of Organization Running Log	

TYPE OF COMPLETION: (Circle One or More):  
**Gravel Packed**, Underreamed, Telescoped,  
Natural Development, Open Hole, Other

<b>GEOLOGIC DATA (Office Use Only)</b>			
Surface Elev.	Geologic Unit	Unit Thickness	Depth to Top
Subs. SWL	Date	Analysis	Aquifer Test

WELL GROUTED TO A DEPTH OF **3** FEET  
Type Grout (circle one): **Cement**, Bentonite, or Mix

Driller's Remarks	
Top of Lap Pipe or Reduction in Casing	
FEET	IF TELESCOPED OR MORE THAN ONE SCREEN: USE BACK PAGE


<b>SCREEN DATA</b>		
Diameter - Inches <b>4</b>	Length - Feet <b>10</b>	Slot Size - Inches <b>1014</b>
Screen Type <b>PVC Slot</b>	Depth to Bottom - Feet <b>132</b>	

DESCRIPTION OF FORMATIONS ENCOUNTERED	FROM	TO
<b>Red &amp; White Clay</b>	<b>0</b>	<b>20</b>
<b>White Clay &amp; Sand</b>	<b>20</b>	<b>60</b>
<b>White Sand</b>	<b>60</b>	<b>142</b>

FORMATIONS (Continued)	FROM	TO
<b>RECEIVED</b>		
<b>APR 02 1999</b>		
Dept. of Environmental Quality Office of Land & Water Resources		
IF MORE SPACE IS NEEDED, USE BACK		

If well telescopes please  
sketch and show depths.

GROUND LEVEL

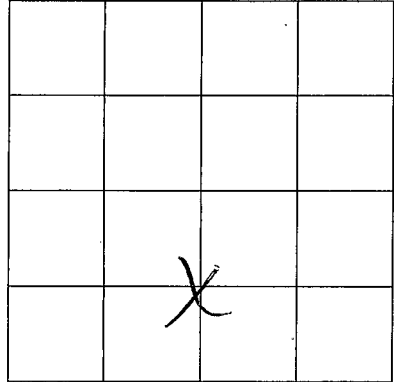

SECTION 32

Please indicate well location X.

ADDITIONAL INFORMATION

If more than one screen,  
show location of each on sketch.