

TATE
 CI
 11-2-70

MISSISSIPPI
 BOARD OF WATER COMMISSIONERS
 416 North State Street
 Jackson, Mississippi 39201

CODED

WATER WELL DRILLERS LOG

11-2 1970 Harris Bros. Fate
 date well completed firm name county well located

LANDOWNER: W. S. Wallace
 Rt. 3
 Coldwater
 (mailing address)

description of formations encountered	from	to
top soil	0	20
clay + sand	20	65
white clay	65	125
coarse sand	125	150

WELL LOCATION:
 sec. 13 T. 4 N. R. 60 E
 4 miles NE of Independence
 (distance) (direction) (nearest town)

WELL PURPOSE: none
 (home, irrigation, municipal, industrial)

WELL COMPLETION DATA:
 (1) diameter (inches) 4
 (2) total depth (feet) 150
 (3) static water level (feet) 60 ^{below}/_{above} top of ground.
 (4) casing Plastic, 136
 (material) (depth)
 4 if telescope see back.
 (size)
 (5) screen 14 136
 (length) (depth to top)
 008 Plastic
 (size) (material)
 (6) pump 3/4 10
 (HP) (yield gpm)
 elec.
 (type power)
 (7) electric log NO
 (yes or no)

CODED

(organization running log)
 (8) how well bottom plugged back shot


MAY 3 - 1971

DRILLERS REMARKS:

MISS. BD. OF
 WATER COMM.

If well telescopes please sketch and show depths.

GROUND LEVEL

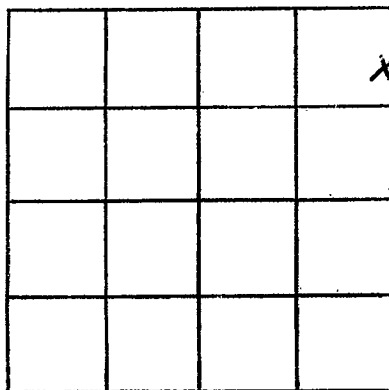

SECTION 13

Please indicate well location X.

ADDITIONAL INFORMATION

If more than one screen,
show locations of each on sketch.