

TATE  
C 3  
2-10-71

MISSISSIPPI  
BOARD OF WATER COMMISSIONERS  
416 North State Street  
Jackson, Mississippi 39201

**CODED**

WATER WELL DRILLERS LOG

2-10 1971 Harris Bros. Tate  
date well completed firm name county well located

LANDOWNER: Sister Graham  
pt. 3  
Coldwater  
(mailing address)

description of formations encountered	from	to
top soil	0	15
white clay	15	45
clay + sand	45	90
coarse sand	90	100

WELL LOCATION:  
sec. 11 T 4 N R. 6 E  
2 1/2 miles N of Independence  
(distance) (direction) (nearest town)

WELL PURPOSE: none  
(home, irrigation, municipal, industrial)

- WELL COMPLETION DATA:
- (1) diameter (inches) 4
  - (2) total depth (feet) 100
  - (3) static water level (feet) 60 below top of ground.
  - (4) casing Plastic, 93  
(material) (depth)
  - 4 if telescope see back.  
(size)
  - (5) screen 7', 93'  
(length) (depth to top)
  - 008 Plastic  
(size) (material)
  - (6) pump 3/4, 10  
(HP) (yield gpm)
  - elec.  
(type power)
  - (7) electric log no  
(yes or no)

**CODED**


(organization running log)  
(8) how well bottom plugged truck  
shot

MAY 11 1971

DRILLERS REMARKS:

If well telescopes please sketch and show depths.

GROUND LEVEL

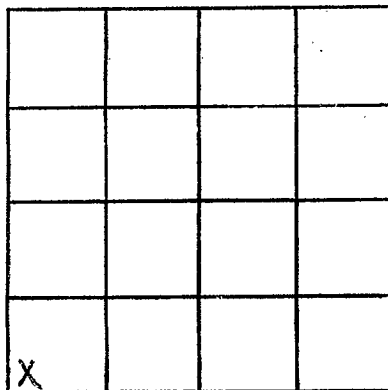

SECTION 11

Please indicate well location X.

ADDITIONAL INFORMATION

If more than one screen,  
show locations of each on sketch.