

TATE
C 4
2-20-71

MISSISSIPPI
BOARD OF WATER COMMISSIONERS
416 North State Street
Jackson, Mississippi 39201

CODED

WATER WELL DRILLERS LOG

2-20 1971 date well completed Harris Bros. firm name Tate county well located

LANDOWNER: Zellie Purgana
pt. 2
Coldwater
(mailing address)

description of formations encountered	from	to
top soil	0	25
clay + sand	25	60
white clay	60	110
clay + sand	110	140
course sand	140	170

WELL LOCATION:
sec. 14 T 4 N 3 R 1 E W
2 miles N of Independence
(distance) (direction) (nearest town)

WELL PURPOSE: none
(home, irrigation, municipal, industrial)

WELL COMPLETION DATA:

(1) diameter (inches) 4

(2) total depth (feet) 170

(3) static water level (feet) 90 below top of ground.

(4) casing plastic, 156 (material) (depth)

4 if telescope see back. (size)

(5) screen 14, 156 (length) (depth to top)

008, plastic (size) (material)

(6) pump 1 1/2, 30 (HP) (yield gpm)

elec. (type power)

(7) electric log no (yes or no)

(organization running log)

(8) how well bottom plugged much
short


CODED

MAY 14 1971

DRILLERS REMARKS:

If well telescopes please sketch and show depths.

GROUND LEVEL

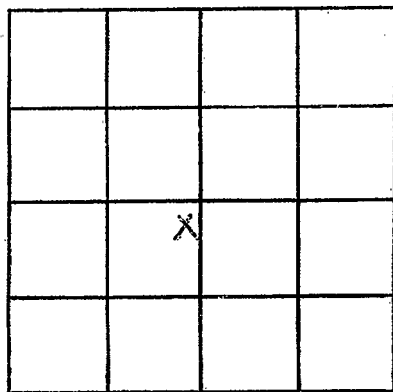

SECTION 14

Please indicate well location X.

ADDITIONAL INFORMATION

If more than one screen,
show locations of each on sketch.