

MISSISSIPPI
BOARD OF WATER COMMISSIONERS
416 North State Street
Jackson, Mississippi 39201

CODED

WATER WELL DRILLERS LOG

TATE
CS
3-1-71

3-1-71 date well completed Harris Bros. firm name Tate county well located

LANDOWNER: William Massey
Rt. 3
Coldwater
(mailing address)

WELL LOCATION:
sec 20 T 4 N 3 R 6 E 17
3 miles NW of Clarks
(distance) (direction) (nearest town)

description of formations encountered	from	to
<u>top soil</u>	<u>0</u>	<u>15</u>
<u>clay + sand</u>	<u>15</u>	<u>85</u>
<u>coarse sand</u>	<u>85</u>	<u>100</u>

WELL PURPOSE: home
(home, irrigation, municipal, industrial)

WELL COMPLETION DATA:

(1) diameter (inches) 4

(2) total depth (feet) 100

(3) static water level (feet) 60 ^{below} above top of ground.

(4) casing Plastic, 93
(material) (depth)

4 if telescope see back.
(size)

(5) screen 7, 93
(length) (depth to top)

008, Plastic
(size) (material)

(6) pump 3/4, 7
(HP) (yield gpm)

elec.
(type power)

(7) electric log no
(yes or no)

CODED

(organization running log)

(8) how well bottom plugged work
shot


MAY 14 1971

MISS. BD. OF
WATER COMMISSIONERS

DRILLERS REMARKS:

If well telescopes please sketch and show depths.

GROUND LEVEL

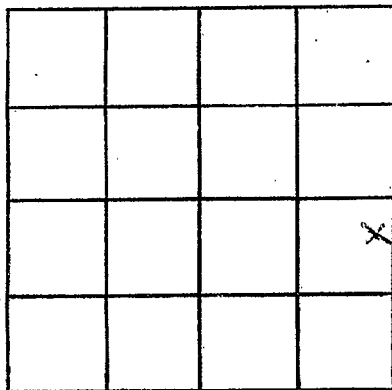

SECTION 20

Please indicate well location X.

ADDITIONAL INFORMATION

If more than one screen, show locations of each on sketch.