

MISSISSIPPI
BOARD OF WATER COMMISSIONERS
416 North State Street
Jackson, Mississippi 39201

CODED

WATER WELL DRILLERS LOG

TATE
C 6
3-27-71

3-27 19 71 date well completed
Harris Bros. firm name
Tate county well located

LANDOWNER: J. W. Busby
pt. 3
Coldwater
(mailing address)

description of formations encountered	from	to
top soil	0	15
sand & clay	15	85
Coarse sand	85	100

WELL LOCATION:
sec. 25 T 4 N R. 6 E
1 1/2 miles E of Independence
(distance) (direction) (nearest town)

WELL PURPOSE: home
(home, irrigation, municipal, industrial)

- WELL COMPLETION DATA:
- (1) diameter (inches) 4
 - (2) total depth (feet) 100
 - (3) static water level (feet) 60 ^{below} top of ground.
 - (4) casing Plastic, 93, (material) (depth)
 - 4 (size) if telescope see back.
 - (5) screen 7', 93 (length) (depth to top)
 - 008, Plastic (size) (material)
 - (6) pump 3/4 7 (HP) (yield gpm)
 - elec. (type power)
 - (7) electric log no (yes or no)

CODED

(organization running log)
(8) how well bottom plugged with shot


MAY 14 1971

DRILLERS REMARKS:

MISS. BD. OF
WATER COM.

If well telescopes please sketch and show depths.

GROUND LEVEL

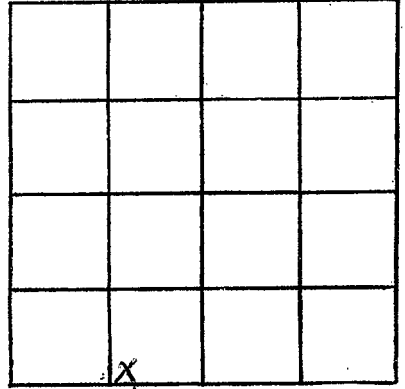

SECTION 25

Please indicate well location X.

ADDITIONAL INFORMATION

If more than one screen, show locations of each on sketch.