

TATE
C 9
8-28-71

MISSISSIPPI
BOARD OF WATER COMMISSIONERS
416 North State Street
Jackson, Mississippi 39201

WATER WELL DRILLERS LOG

CODED

8-28-71 1971 Bob Smith Tate
date well completed firm name county well located

LANDOWNER:	description of formations encountered	from	to
<u>L. B. Madam</u>			
<u>Andy Adams, Miss.</u> (mailing address)	<u>top 3' soil</u>	<u>0</u>	<u>5</u>
	<u>red clay</u>	<u>5</u>	<u>30</u>
	<u>red sand</u>	<u>20</u>	<u>40</u>
	<u>red gravel</u>	<u>40</u>	<u>60</u>
	<u>white sand</u>	<u>60</u>	<u>140</u>

WELL LOCATION:
sec. 8 T. 4 N. R. 6 E.
7 miles North of Inde
(distance) (direction) (nearest town)

WELL PURPOSE: Home
(home, irrigation, municipal, industrial)

WELL COMPLETION DATA:

(1) diameter (inches) 4

(2) total depth (feet) 140

(3) static water level (feet) 100 below above top of ground.

(4) casing Plastic 140
(material) (depth)
(size) If telescope see back.

(5) screen 20 120
(length) (depth to top)
4 Plastic
(size) (material)

(6) pump 1/2 10
(HP) (yield gpm)
Elec
(type power)

(7) electric log no
(yes or no)
(organization running log)

(8) how well bottom plugged plugged

CODED


NOV 22 1971

MISS. BD. OF
WATER COMM.

DRILLERS REMARKS:

If well telescopes please sketch and show depths.

GROUND LEVEL

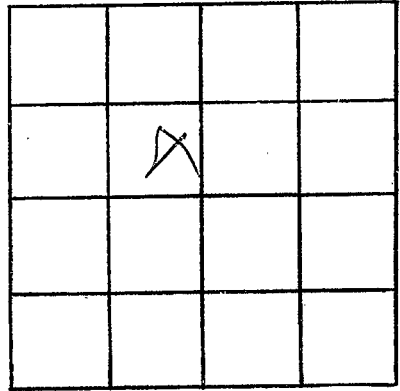

SECTION _____

Please indicate well location X.

ADDITIONAL INFORMATION

If more than one screen, show locations of each on sketch.