

Jato
c 11
2-12-68

MISSISSIPPI
 BOARD OF WATER COMMISSIONERS
 416 North State Street
 Jackson, Mississippi 39201

CODED

WATER WELL DRILLERS LOG

CODED

2-12 1968 Harris Bros. Jato
 date well completed firm name county well located

LANDOWNER: Chester Roberts
RT. 2
Coldwater Miss
 (mailing address)

description of formations encountered	from	to
<u>top soil</u>	<u>0</u>	<u>20</u>
<u>white clay</u>	<u>20</u>	<u>45</u>
<u>clay and sand</u>	<u>45</u>	<u>115</u>
<u>white sand</u>	<u>115</u>	<u>120</u>

WELL LOCATION:
 sec. 8 T. 4 N. R. 5 E
5 miles NW of Independence
 (distance) (direction) (nearest town)

WELL PURPOSE: home
 (home, irrigation, municipal, industrial)

- WELL COMPLETION DATA:
- (1) diameter (inches) 4"
 - (2) total depth (feet) 130
 - (3) static water level (feet) 60 below top of ground.
 - (4) casing plastic, 123'
 (material) (depth)
 - 4 (size) If telescope see back.
 - (5) screen 7', 123'
 (length) (depth to top)
 - 008, plastic
 (size) (material)
 - (6) pump 3/4, 7
 (HP) (yield gpm)
 - elect.
 (type power)
 - (7) electric log no
 (yes or no)

CODED


(organization running log)
 (8) how well bottom plugged wuck
shot

DRILLERS REMARKS:

APR 1968
 MISSISSIPPI BOARD OF WATER COMMISSIONERS

If well telescopes please sketch and show depths.

GROUND LEVEL

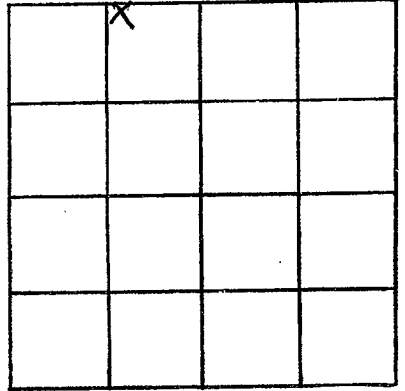

SECTION 8

Please indicate well location X.

ADDITIONAL INFORMATION

If more than one screen,
show locations of each on sketch.