

Date  
 C 12  
 2-5-68

MISSISSIPPI  
 BOARD OF WATER COMMISSIONERS  
 416 North State Street  
 Jackson, Mississippi 39201

CODED

WATER WELL DRILLERS LOG

2-5 1968 Harris Bros. Tate  
 date well completed firm name county well located

LANDOWNER: Paul  
 Poindexter Jr.  
 P.O. 3 Coldwater  
 (mailing address)

description of formations encountered	from	to
top shot	0	15
red sand	15	40
white clay	40	65
clay + sand	65	110
coarse sand	110	123

WELL LOCATION:  
 sec. 7 T 4 N R 6 E  
 8 miles NW of Clarksden  
 (distance) (direction) (nearest town)

WELL PURPOSE: home  
 (home, irrigation, municipal, industrial)

- WELL COMPLETION DATA:
- (1) diameter (inches) 4"
  - (2) total depth (feet) 123
  - (3) static water level (feet) 80 <sup>(below)</sup> top of ground.
  - (4) casing Plastic 1 1/2" (material) (depth)  
 4" (size) if telescope see back.
  - (5) screen 7' (length) 1 1/2' (depth to top)  
 1/2" (size) Plastic (material)
  - (6) pump 3/4" (HP) 7 (yield gpm)  
 elec. (type power)
  - (7) electric log ml (yes or no)

CODED


(organization running log)  
 (8) how well bottom plugged truck shot

DRILLERS REMARKS:

FEB 29 1968  
 MISS. BD. OF  
 WATER COMMISSIONERS

If well telescopes please sketch and show depths.

GROUND LEVEL

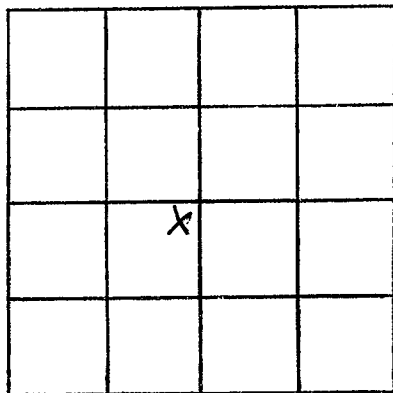

SECTION 7

Please indicate well location X.

ADDITIONAL INFORMATION

If more than one screen, show locations of each on sketch.