

Date  
 13  
 3-1-68

MISSISSIPPI  
 BOARD OF WATER COMMISSIONERS **CODED**  
 416 North State Street  
 Jackson, Mississippi 39201

WATER WELL DRILLERS LOG

3-1 1968 Harris Bros Tate  
 date well completed firm name county well located

LANDOWNER: Albert Moore  
 P.O. Box  
 Independence  
 (mailing address)

description of formations encountered	from	to
top soil	0	20
red sand	20	35
white clay	35	75
clay + sand	75	120
course sand	120	140

WELL LOCATION:  
 sec 35 T 4 N R 6 E  
 1 1/2 miles East of Independence  
 (distance) (direction) (nearest town)

WELL PURPOSE: none  
 (home, irrigation, municipal, industrial)

**CODED**

WELL COMPLETION DATA:

- (1) diameter (inches) 4
- (2) total depth (feet) 140
- (3) static water level (feet) 80 <sup>(below)</sup> <sub>above</sub> top of ground.
- (4) casing Plastic 126 (material) (depth)  
 4" (size) if telescope see back.
- (5) screen 14' (length) 126 (depth to top)  
 1/2" Plastic (size) (material)
- (6) pump 74 (HP) 10 (yield gpm)  
 elec. (type power)
- (7) electric log no (yes or no)
- (organization running log)
- (8) how well bottom plugged back shot


DRILLERS REMARKS:

DEC 23 1968

MRS. DE W  
 WATER BOARD

If well telescopes please sketch and show depths.

GROUND LEVEL

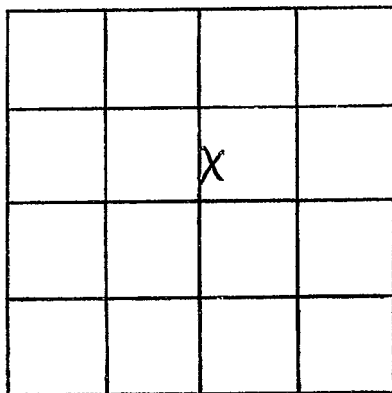

SECTION 35

Please indicate well location X.

ADDITIONAL INFORMATION

If more than one screen, show locations of each on sketch.