

CODED

MISSISSIPPI
BOARD OF WATER COMMISSIONERS
416 North State Street
Jackson, Mississippi 39201

CODED

WATER WELL DRILLERS LOG

Date
C14
2-68

2 1968 Harris Bros. Tate
date well completed firm name county well located

LANDOWNER: Independence

description of formations encountered

from to

Church of Christ
Rt. 2 Coldwater
(mailing address)

top soil
red sand
clay + sand
fine sand
course sand

0 20
20 35
35 80
80 120
120 130

WELL LOCATION:

sect 15 T 4 N R 6 E
S miles N of Independence
(distance) (direction) (nearest town)

WELL PURPOSE: Church
(home, irrigation, municipal, industrial)

WELL COMPLETION DATA:

- (1) diameter (inches) 4"
- (2) total depth (feet) 130
- (3) static water level (feet) 123 ²⁰ below top of ground.
- (4) casing plastic 123' (material) (depth)
4" (size) if telescope see back.
- (5) screen 7' (length) 123' (depth to top)
1/2" 1008 plastic (size) (material)
- (6) pump 3/4 (HP) 10 (yield gpm)
elec (type power)
- (7) electric log No (yes or no)

CODED

(organization running log)

(8) how well bottom plugged back shot


DRILLERS REMARKS:

DEC 23 1968

MISS. DE. OF WATER COMMISSIONERS

If well telescopes please sketch and show depths.

GROUND LEVEL

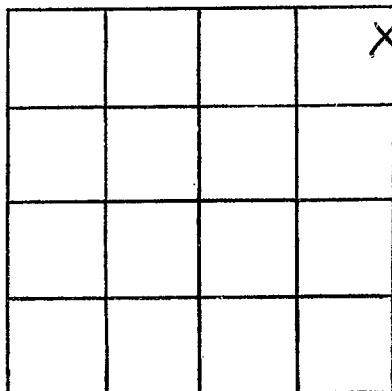

SECTION 15

Please indicate well location X.

ADDITIONAL INFORMATION

If more than one screen,
show locations of each on sketch.