

CODED

MISSISSIPPI
BOARD OF WATER COMMISSIONERS
416 North State Street
Jackson, Mississippi 39201

CODED

WATER WELL DRILLERS LOG

Date
C 15
3-10-68

3-10 date well completed 19 68 firm name Harris Bros Tate county well located

LANDOWNER: Louise Ferguson
Rte 2 Coldwater
 (mailing address)

description of formations encountered	from	to
top soil	0	20
red sand	20	40
clay + sand	40	85
course sand	85	100

WELL LOCATION:
 sec 27 T 4 N R 6 E
1 miles W of Independence
 (distance) (direction) (nearest town)

WELL PURPOSE: None
 (home, irrigation, municipal, industrial)

WELL COMPLETION DATA:

(1) diameter (inches) 4"

(2) total depth (feet) 100

(3) static water level (feet) 100 ^{below} _{above} top of ground.

(4) casing Plastic 93'
 (material) (depth)
4" if telescope see back.
 (size)

(5) screen 7' 93'
 (length) (depth to top)
008 Plastic
 (size) (material)

(6) pump 3/4 7
 (HP) (yield gpm)
elec.
 (type power)

(7) electric log NO
 (yes or no)

(organization running log) _____

(8) how well bottom plugged back
shot

CODED


DEC 23 1968

MISS. BD. OF
WATER COM.

DRILLERS REMARKS:

If well telescopes please sketch and show depths.

GROUND LEVEL

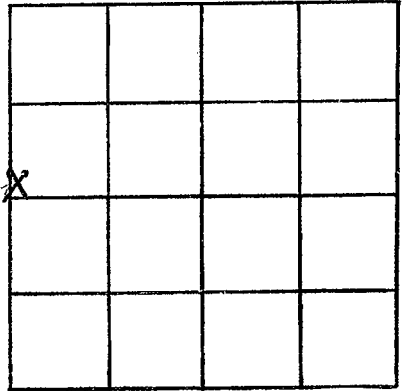

SECTION 27

Please indicate well location X.

ADDITIONAL INFORMATION

If more than one screen, show locations of each on sketch.