

MISSISSIPPI
BOARD OF WATER COMMISSIONERS
416 North State Street
Jackson, Mississippi 39201

CODED

CODED

WATER WELL DRILLERS LOG

Date
C 16
1-11-69

JAN 11 1969 date well completed JIM PENIX firm name TATE county well located


LANDOWNER: <u>BYRON L. HARRIS</u> <u>80 PONTIAC</u> BYRON L. HARRIS <u>HERNANDO MISS</u> (mailing address)	description of formations encountered	from	to
	CLAY	0	5
	GRAVEL	5	10.7
	SAND	10.7	11.7
<p>WELL LOCATION:</p> <p>sec. <u>30 T 4 N</u> R <u>6 E</u> S W</p> <p><u>6</u> miles <u>EAST</u> of <u>COLDWATER</u> (distance) (direction) (nearest town)</p>			
<p>WELL PURPOSE: <u>HOME</u> (home, irrigation, 'municipal,' industrial)</p>			
<p>WELL COMPLETION DATA:</p> <p>(1) diameter (inches) <u>2 IN</u></p> <p>(2) total depth (feet) <u>10.7 FT</u></p> <p>(3) static water level (feet) <u>77</u> below above top of ground.</p> <p>(4) casing <u>GAL. 1 1/2</u>, <u>113</u>, (material) (depth) <u>1 1/2</u> if telescope see back. (size) <u>4 FT.</u></p> <p>(5) screen <u>4 FT</u>, (length) (depth to top) <u>1 1/2</u>, <u>BRASS</u> (size) (material)</p> <p>(6) pump _____ (HP) (yield gpm) (type power) _____</p> <p>(7) electric log _____ (yes or no) (organization running log) _____</p> <p>(8) how well bottom plugged _____</p>			
<p>DRILLERS REMARKS: <u>OWNER INSTALLED</u> <u>OWN PUMP</u></p>			

CODED

FEB - 9 1969

MISS. BD. OF
WATER COM.

If well telescopes please sketch and show depths.

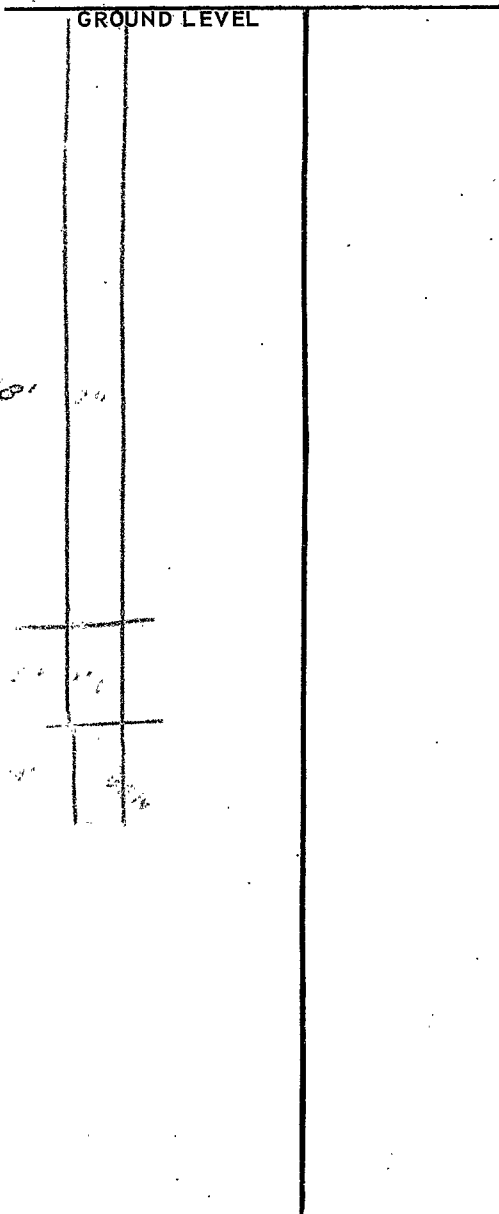

			X

SECTION 30

Please indicate well location X.

ADDITIONAL INFORMATION

If more than one screen, show locations of each on sketch.