

Tate  
C19  
5-18-68

MISSISSIPPI  
BOARD OF WATER COMMISSIONERS  
416 North State Street  
Jackson, Mississippi 39201

CODED

WATER WELL DRILLERS LOG

5-18 19 1968 Horriboze Tate  
date well completed firm name county well located

LANDOWNER: Sube Sullivan  
Rte 3  
Caldwater  
(mailing address)

description of formations encountered	from	to
top soil	0	15
white clay	15	45
clay sand	45	85
sh. sand	85	110

WELL LOCATION:  
sec. 2 T 4 N R. 6 E  
4 miles N of Independence  
(distance) (direction) (nearest town)

WELL PURPOSE: pond  
(home, irrigation, municipal, industrial)

WELL COMPLETION DATA:  
(1) diameter (inches) 4"  
(2) total depth (feet) 110  
(3) static water level (feet) 20 below above top of ground.  
(4) casing Plastic, 103,  
(material) (depth)  
4"  
(size) if telescope see back.  
(5) screen 7', 103  
(length) (depth to top)  
.008, plastic  
(size) (material)  
(6) pump 3/4, 7  
(HP) (yield gpm)  
elc  
(type power)  
(7) electric log no  
(yes or no)

CODED

(organization running log)  
(8) how well bottom plugged well  
shut


MAR 7 1969

MISS. BD. OF  
WATER COMM.

DRILLERS REMARKS: \_\_\_\_\_

If well telescopes please sketch and show depths.

GROUND LEVEL

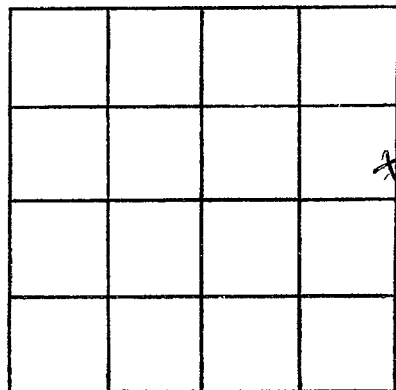

SECTION 2

Please indicate well location X.

ADDITIONAL INFORMATION

If more than one screen,  
show locations of each on sketch.