

Tate  
C20  
6-10-68

MISSISSIPPI  
BOARD OF WATER COMMISSIONERS  
416 North State Street  
Jackson, Mississippi 39201

CODED

WATER WELL DRILLERS LOG

6-10 1968 Harris Bros Tate  
date well completed firm name county well located

LANDOWNER: Roy Power  
pts. 2  
Coldwater  
(mailing address)

description of formations encountered	from	to
top soil	0	20
W. clay	20	65
W. clay + sand	65	125
W. sand	125	140

WELL LOCATION:  
sec 32 T 4 N R 6 E  
8 1/2 miles E of Coldwater  
(distance) (direction) (nearest town)

WELL PURPOSE: none  
(home, irrigation, municipal, industrial)

- WELL COMPLETION DATA:
- (1) diameter (inches) 4"
  - (2) total depth (feet) 140
  - (3) static water level (feet) 80 below top of ground.
  - (4) casing Plastic, 133 (material) (depth)  
4" (size) if telescope see back.
  - (5) screen 7', 133 (length) (depth to top)  
.008 Plastic (size) (material)
  - (6) pump 3/4 (HP) 7 (yield gpm)  
elec (type power)
  - (7) electric log no (yes or no)  
(organization running log)
  - (8) how well bottom plugged back shot

CODED


MAR 7 1969

MISS. BD. OF WATER COMM.

DRILLERS REMARKS:

If well telescopes please sketch and show depths.

GROUND LEVEL

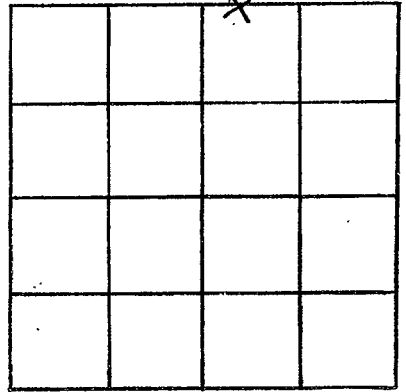

SECTION 32

Please indicate well location X.

ADDITIONAL INFORMATION

If more than one screen, show locations of each on sketch.