

CODED

MISSISSIPPI  
BOARD OF WATER COMMISSIONERS  
416 North State Street  
Jackson, Mississippi 39201

WATER WELL DRILLERS LOG

Tate  
C21  
6-20-68

10-20 1968 Harry Cross Tate  
date well completed firm name county well located

LANDOWNER: John Darnell  
pte. 3  
Coldwater  
(mailing address)

description of fomations encountered	from	to
top soil	0	20
W. clay + sand	20	120
W. sand	120	150

WELL LOCATION:  
sec 25 T 4 N R 6 E  
2 miles E of Independence  
(distance) (direction) (nearest town)

WELL PURPOSE: home + barn  
(home, irrigation, municipal, industrial)

- WELL COMPLETION DATA:
- (1) diameter (inches) 4
  - (2) total depth (feet) 150
  - (3) static water level (feet) 80 <sup>below</sup> top of ground.
  - (4) casing Plastic, 136 (material) (depth)  
4" (size) if telescope see back.
  - (5) screen 14' (length) 136 (depth to top)  
008 (size) Plastic (material)
  - (6) pump 1/2 (HP) 25 (yield gpm)  
elec. (type power)
  - (7) electric log no (yes or no)
  - (organization running log)
  - (8) how well bottom plugged suck

CODED


MAR 7 1969

MISS. BD. OF  
WATER COMM.

DRILLERS REMARKS:

If well telescopes please sketch and show depths.

GROUND LEVEL

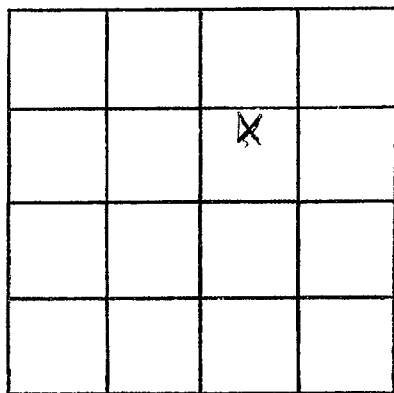

SECTION 25

Please indicate well location X.

ADDITIONAL INFORMATION

If more than one screen,  
show locations of each on sketch.