

Tate.
C 24
7-68

MISSISSIPPI
BOARD OF WATER COMMISSIONERS
416 North State Street
Jackson, Mississippi 39201

CODED

WATER WELL DRILLERS LOG

7-29 1968 Harris Bros Tate
date well completed firm name county well located

LANDOWNER James Darnell
rte 3
Caldwater
(mailing address)

description of formations encountered	from	to
top soil	0	20
w/ clay	20	60
clay + sand	60	120
fine sand	120	135
course w. sand	135	160

WELL LOCATION:
sec. 1 T 4 N R 6 E
7 1/2 miles N.E. of Independence
(distance) (direction) (nearest town)

WELL PURPOSE: none - barn
(home, irrigation, municipal, industrial)

CODED

WELL COMPLETION DATA:
(1) diameter (inches) 4"
(2) total depth (feet) 160
(3) static water level (feet) 100 below above top of ground.
(4) casing Plastic 1 1/2" (material) (depth) 4" (size) If telescope see back.
(5) screen 14" (length) 146" (depth to top) .008" (size) Plastic (material)
(6) pump 2 (HP) 30 (yield gpm) elec (type power)
(7) electric log no (yes or no)
(organization running log)
(8) how well bottom plugged back shut


MAR 10 1969

DRILLERS REMARKS:

MISS. Bd. of
WATER COMMISSIONERS

If well telescopes please sketch and show depths.

GROUND LEVEL

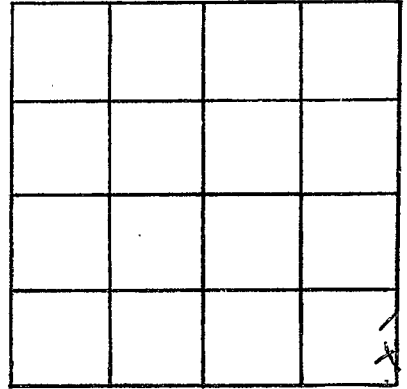

SECTION 1

Please indicate well location X.

ADDITIONAL INFORMATION

If more than one screen,
show locations of each on sketch.